

~~XXXXXXXXXX~~

## GENERAL Standard DETAILS

### STANDARD DETAIL DRAWINGS INDEX

~~S-050~~ STANDARD UTILITY LOCATIONS

~~Standard Utility~~

WATER LINE & Sewer LINE  
SEPARATION

~~S-100~~ ~~MANHOLE~~ TRENCH DETAIL

~~S-100~~ ~~STREET~~ STANDARD ~~Utility Trench Detail Trench - Street Cut.~~

~~S-150~~ PIPE ANCHOR / TRENCH CUT-OFF WALL DETAIL

~~S-200~~ STANDARD MANHOLE Detail (Storm & Sanitary)

~~S-200~~ FLAT-TOP MANHOLE Detail (Storm & Sanitary)

~~S-210~~ MANHOLE BASE STANDARD DETAILS

~~S-220~~ ~~STANDARD INSIDE DROP MANHOLE~~

~~S-220~~ ~~STANDARD OUTSIDE DROP MANHOLE~~

~~S-230~~ ~~MANHOLE COVER AND FRAME DETAILS~~

~~S-260~~ MANHOLE FRAME GRADE ADJUSTMENT

~~S-300~~ ~~TYPICAL PIPE Casing Detail~~

~~S-400~~ ~~TYPICAL PIPE Casing Detail~~

SINGLE & JOINT USE CASING FOR WATER &  
SEWER LINES



City of Coos Bay  
500 Central Ave  
Coos Bay, Oregon 97420  
541.269.8918

H B H  
Consulting  
Engineers



STANDARD DETAIL  
DRAWING INDEX

DETAIL NO.

S-010

12/11/2007



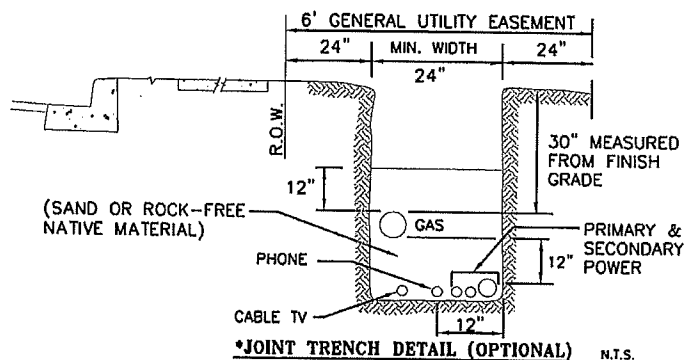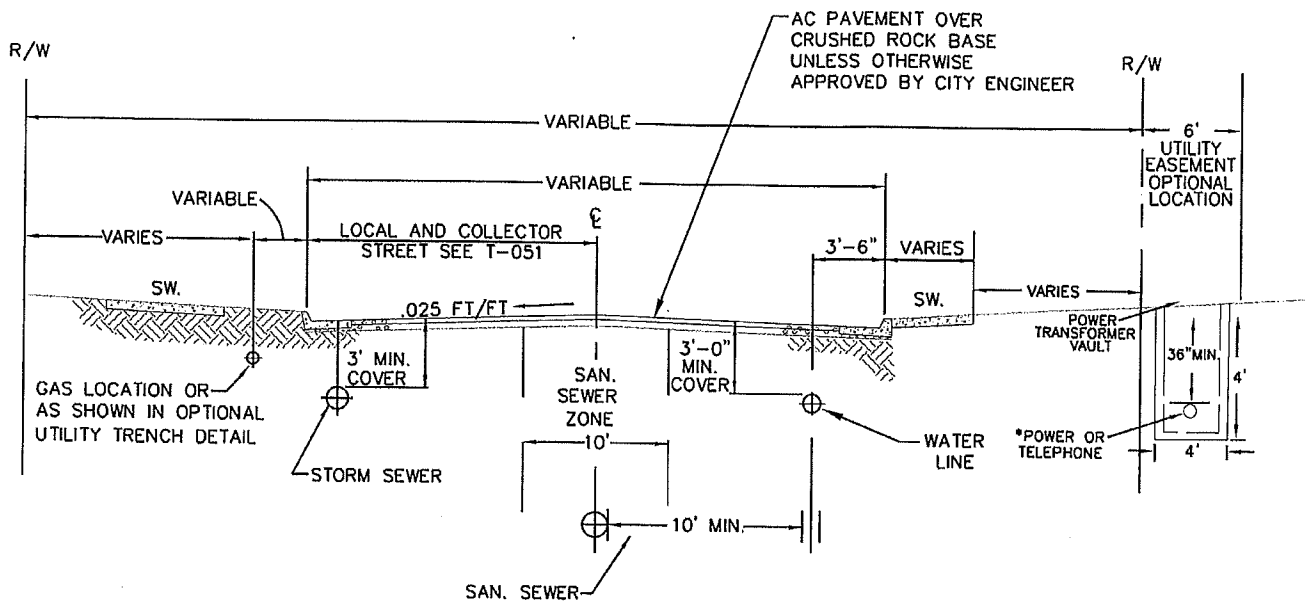

NOTES:

1. WATER MAIN TO BE LOCATED 3'-6" INSIDE FROM FACE OF CURB OR AS OTHERWISE DIRECTED.
2. 10' HORIZONTAL SEPARATION BETWEEN WATER AND SEWER WHERE POSSIBLE. COMPLY WITH SEPARATION REQUIREMENTS OF OAR 333-061-050.
3. WATER DISTRIBUTION MAINS SHALL HAVE 36" MINIMUM COVER OR AS OTHERWISE DIRECTED.
4. SEWER MAINS SHALL HAVE 5.25' (63") MINIMUM COVER UNLESS OTHERWISE APPROVED TO AVOID CONFLICTS WITH WATER AND OTHER UTILITIES.
5. WATER MAINS TO BE LOCATED ON NORTH OR EAST SIDE OF STREET WHEN PRACTICAL.
6. SEWER, STREETS AND DRAINAGE SUBJECT TO CITY STANDARDS.
7. WATER DISTRIBUTION MAINS SUBJECT TO THE COOS BAY/NORTH BEND WATER BOARD.
8. MANHOLE LIDS SHALL NOT BE LOCATED DIRECTLY IN NORMAL WHEEL PATH.
9. ALL LAYOUTS AND LOCATIONS ARE SUBJECT TO CITY APPROVAL.



City of Coos Bay  
500 Central Ave  
Coos Bay, Oregon 97420  
541.269.8918



## STANDARD UTILITY LOCATIONS




DETAIL NO.








5 Service Connections for water and sewer shall be located no closer than 10' Horiz.

DATE :	SCALE :	WATER LINE & SEWER LINE SEPARATION		
6/30/95	NONE			
DRAWING NO.	APPROVED BY :			
	G.KOLB			



WW - WASTEWATER  
 SW - Storm water

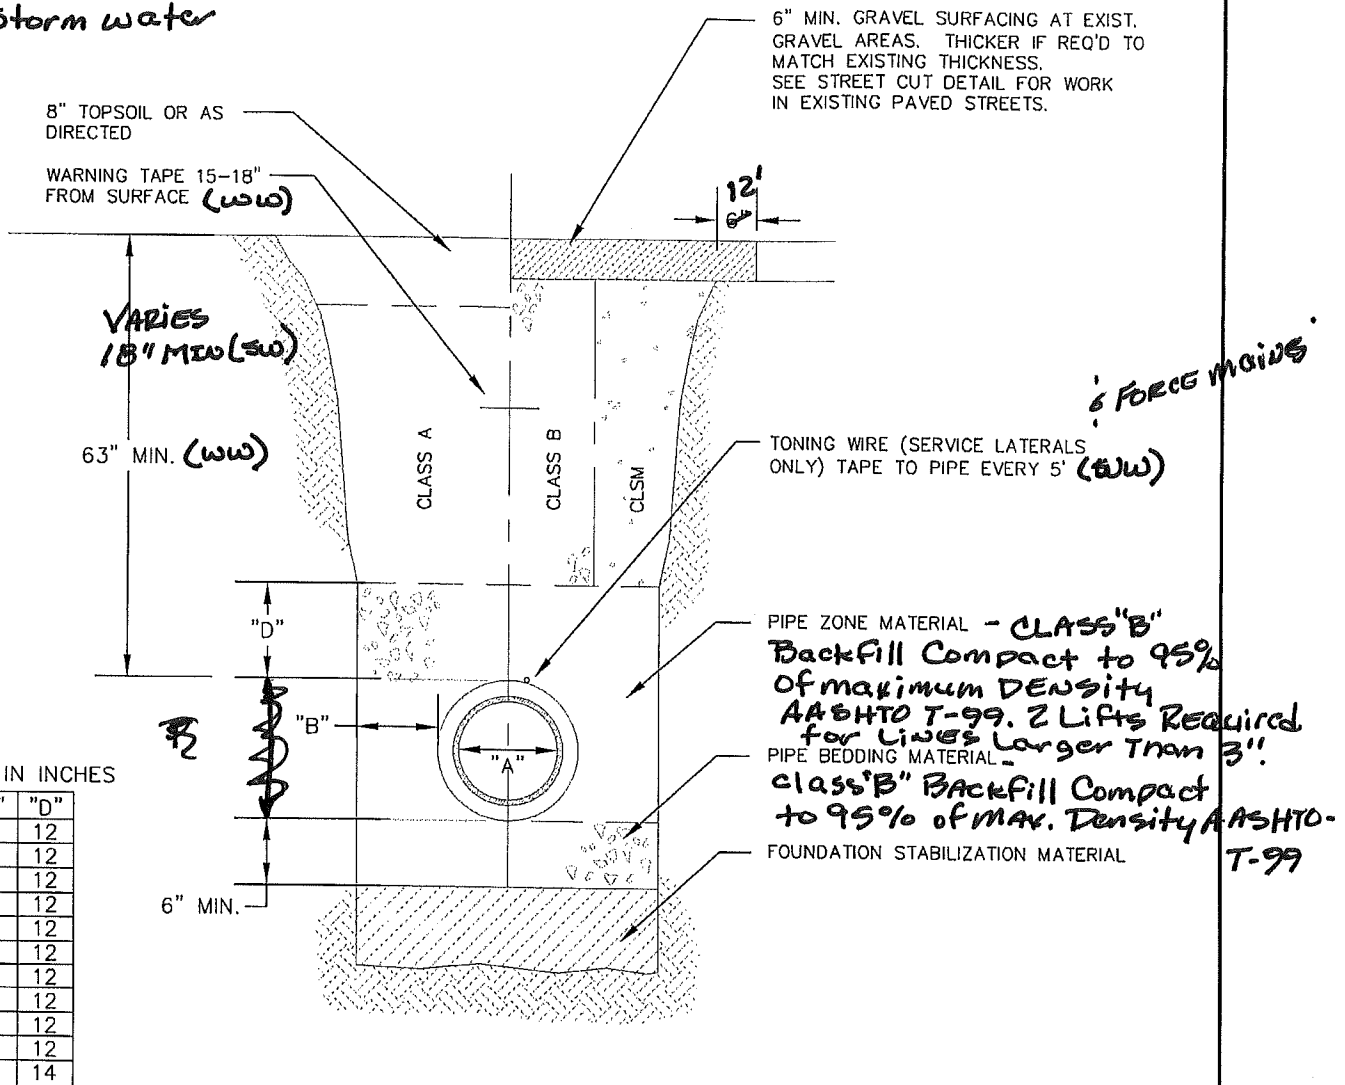

DIMENSIONS IN INCHES

"A"	"B"	"D"
4	10	12
6	10	12
8	10	12
10	10	12
12	12	12
15	12	12
18	16	12
21	16	12
24	18	12
30	18	12
36	24	14

**NOTES:**

1. TRENCH EXCAVATION SHALL BE CONDUCTED IN A SAFE MANNER WITH ALL NECESSARY BRACING AND SHORING PROVIDED FOR COMPLIANCE WITH OSHA.
2. FOUNDATION STABILIZATION SHALL BE PROVIDED WHEN MATERIAL AT BOTTOM OF TRENCH IS UNSUITABLE IN THE OPINION OF THE CITY TO PROVIDE A STABLE TRENCH BASE.
3. CONSTRUCTION IN PUBLIC RIGHT OF WAY SHALL COMPLY WITH CITY STANDARDS.
4. CLASS B BACKFILL REQUIRED IN ALL ROADWAYS AND TRAFFIC PATHS EXCEPT WHERE CLSM BACKFILL IS REQUIRED, BY COUNTY, ODOT, OR CITY.
5. TONING WIRE REQUIRED AT SERVICE LATERALS. WIRE SHALL BE 12 GA. MINIMUM SOLID COPPER WIRE WITH GREEN 30 MIL THICK HDPE INSULATION RATED FOR DIRECT BURY. USE APPROVED WATERPROOF SPLICE AT ALL CONNECTIONS.
6. WARNING TAPE SHALL BE 6" WIDE, 4 MIL THICK, APWA GREEN, READING "CAUTION SEWER LINE BURIED BELOW".
7. MATERIALS SHALL BE IN ACCORDANCE WITH THE CITY ~~SANITARY SEWER DESIGN STANDARDS MANUAL~~ **of Coos Bay Design Manual**
8. COMPACT ALL FILL AS SPECIFIED.

**Standard Utility**



City of Coos Bay  
 500 Central Ave  
 Coos Bay, Oregon 97420  
 541.269.8918




**TYPICAL TRENCH DETAIL**  
**SANITARY SEWER**

DETAIL NO.





5. In situations where ~~concrete~~ <sup>Existing PCC</sup> pavement is overlayed with AC Pavement. Place PCC pavement in accordance to Note 3 w AC Pavement placed in accordance w/ Note 4.

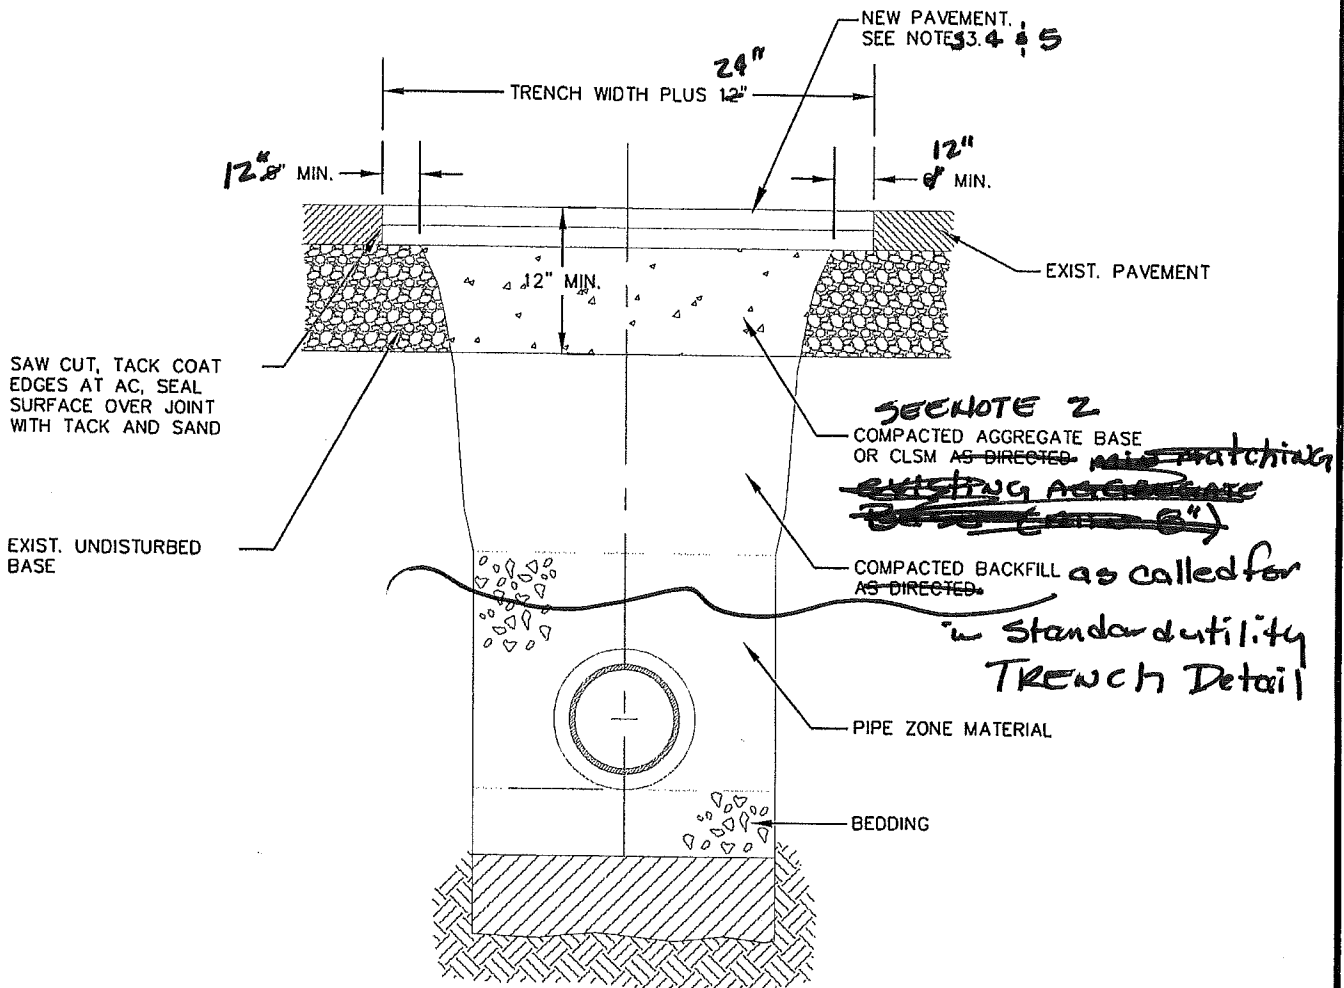

#### NOTES:

1. ALL EXISTING AC OR PCC PAVEMENT SHALL BE SAWCUT IMMEDIATELY PRIOR TO REPAVING.

3. CONCRETE PAVEMENT SHALL BE REPLACED WITH CONCRETE TO A MINIMUM THICKNESS OF 6 INCHES OR TO THE THICKNESS OF REMOVED PAVEMENT, WHICHEVER IS GREATER. ~~dowel bars~~ <sup>smooth 1" dowel bars shall</sup>

4. PLACE AC MIX TO A MINIMUM THICKNESS OF 4 INCHES OR THE THICKNESS OF REMOVED PAVEMENT, WHICHEVER IS GREATER. COMPACT AS DIRECTED. AC PAVEMENT SHALL BE PLACED IN AT LEAST TWO 2" LIFTS.


4. COMPLY WITH THE REQUIREMENTS OF THE AGENCY HAVING JURISDICTION OVER THE ROAD IN WHICH THE STREET CUT OCCURS.

2. <sup>Place</sup> Compacted Aggregate Base or ~~ETB~~ CLSM to a minimum THICKNESS of 8" inches or the thickness of removed ~~Base~~, Aggregate Base, Which ever is Greater. compacted as directed.

Standard Utility Trench Detail



City of Coos Bay  
500 Central Ave  
Coos Bay, Oregon 97420  
541.269.8918

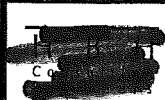


STREET CUT  
STANDARD DETAIL

DETAIL NO.



Be installed @ 12" c/c



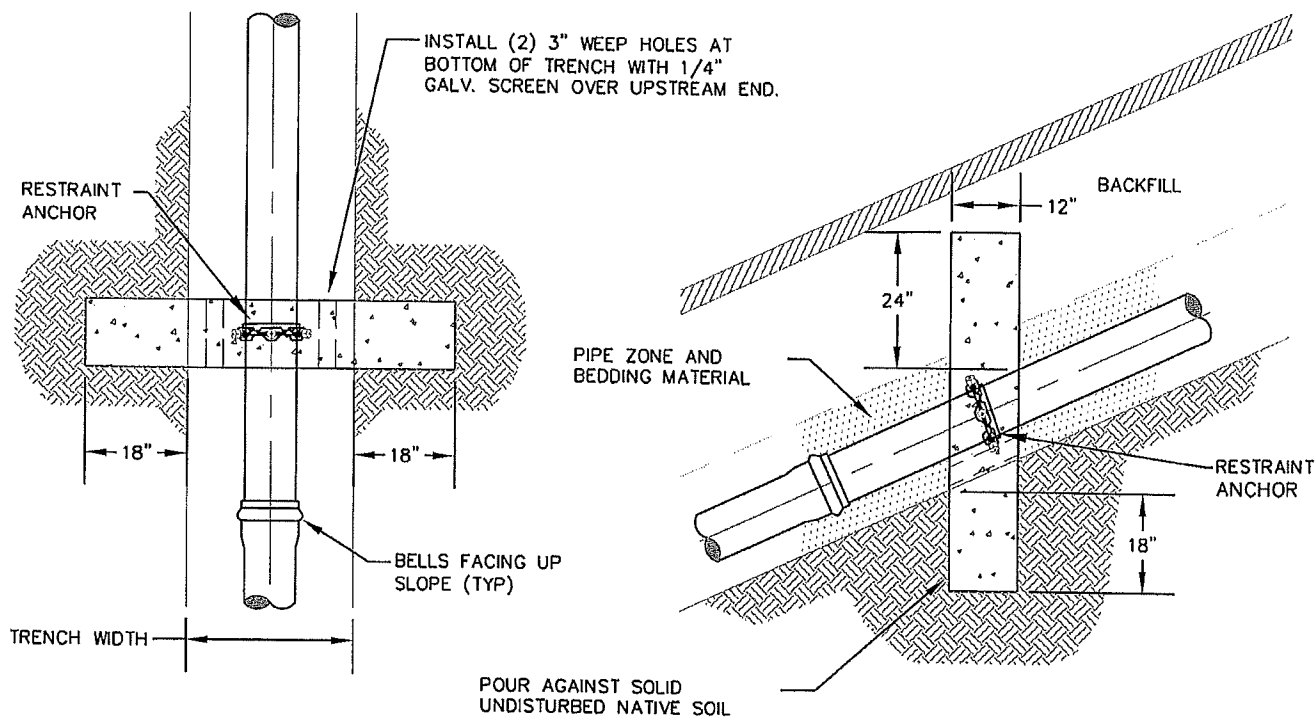

NOTES:

1. CUT-OFF WALLS REQ'D AT ALL PIPELINES WHERE SLOPE EXCEEDS 20%.
2. RESTRAINED JOINT PIPE REQUIRED AT SLOPES BETWEEN 15% AND 20%.
3. WALLS SHALL BE FORMED WITHIN TRENCH. REMOVE FORMS PRIOR TO BACKFILLING.

~~CONCRETE SHALL HAVE 5000 PSI COMPRESSIVE STRENGTH MIN. (CLASS 5000).~~

5. SPACING OF WALLS SHALL BE:

SLOPE	SPACING
20-34%	35 FEET
35-50%	25 FEET
51-+ %	15 FEET



City of Coos Bay  
500 Central Ave  
Coos Bay, Oregon 97420  
541.269.8918



PIPE ANCHOR / TRENCH  
CUT-OFF WALL DETAIL

DETAIL NO.

~~DA-100~~

~~JAN 2008~~



CAST IRON (H-20 RATED)  
MANHOLE COVER AND FRAME=  
SET FRAME IN NON-SHRINK GROUT  
SEE MANHOLE COVER & FRAME  
STANDARD DETAIL ~~(S-250)~~

PRECAST REINFORCED  
GRADE RINGS, 3 LAYERS MAX.  
2" MIN., 12" MAX.  
SET IN NON-SHRINK GROUT.

PRECAST ECCENTRIC CONE  
SLOPE FACING DOWN GRADE

36" TALL 24" OR 36" TALL

KEYED JOINTS WITH PRE-  
FORMED SEAL (RAM-NEK)  
OR RUBBER RING GASKET  
BY MFR. (TYP. ALL JOINTS)  
SEAL WATERTIGHT

FINISH GRADE

26" MAX.

25"

48"

OR  
60"

5" MIN.

THE MAXIMUM PIPE  
SIZE FOR 48" DIA. MH  
IS 24" & FOR 60" DIA.  
MH IS 30". LARGER  
PIPES WILL REQUIRE  
SPECIAL DESIGN &  
APPROVAL FROM  
CITY ENGINEER.

15"-18" TYP.

ALL PRECAST MANHOLE  
SECTIONS SHALL MEET  
ASTM C-478.

FLAT-TOP MANHOLE  
REQUIRED WHEN DEPTH  
FROM FINISH GRADE TO  
INVERT IS LESS THAN  
6 FEET.

INTERIOR DROPS EXCEEDING 24"  
REQUIRE DROP MANHOLE.

SEE MANHOLE BASE  
STANDARD DETAIL ~~(S-210)~~

\\wcd\projects\Coos Bay Dev\Standards\CS Sewer Standards\Details-SEWER.dwg, S-200, 6/5/2008 4:21:54 PM, 12/27/11




City of Coos Bay  
500 Central Ave  
Coos Bay, Oregon 97420  
541.269.8918

STANDARD MANHOLE

DETAIL NO.

DETAIL



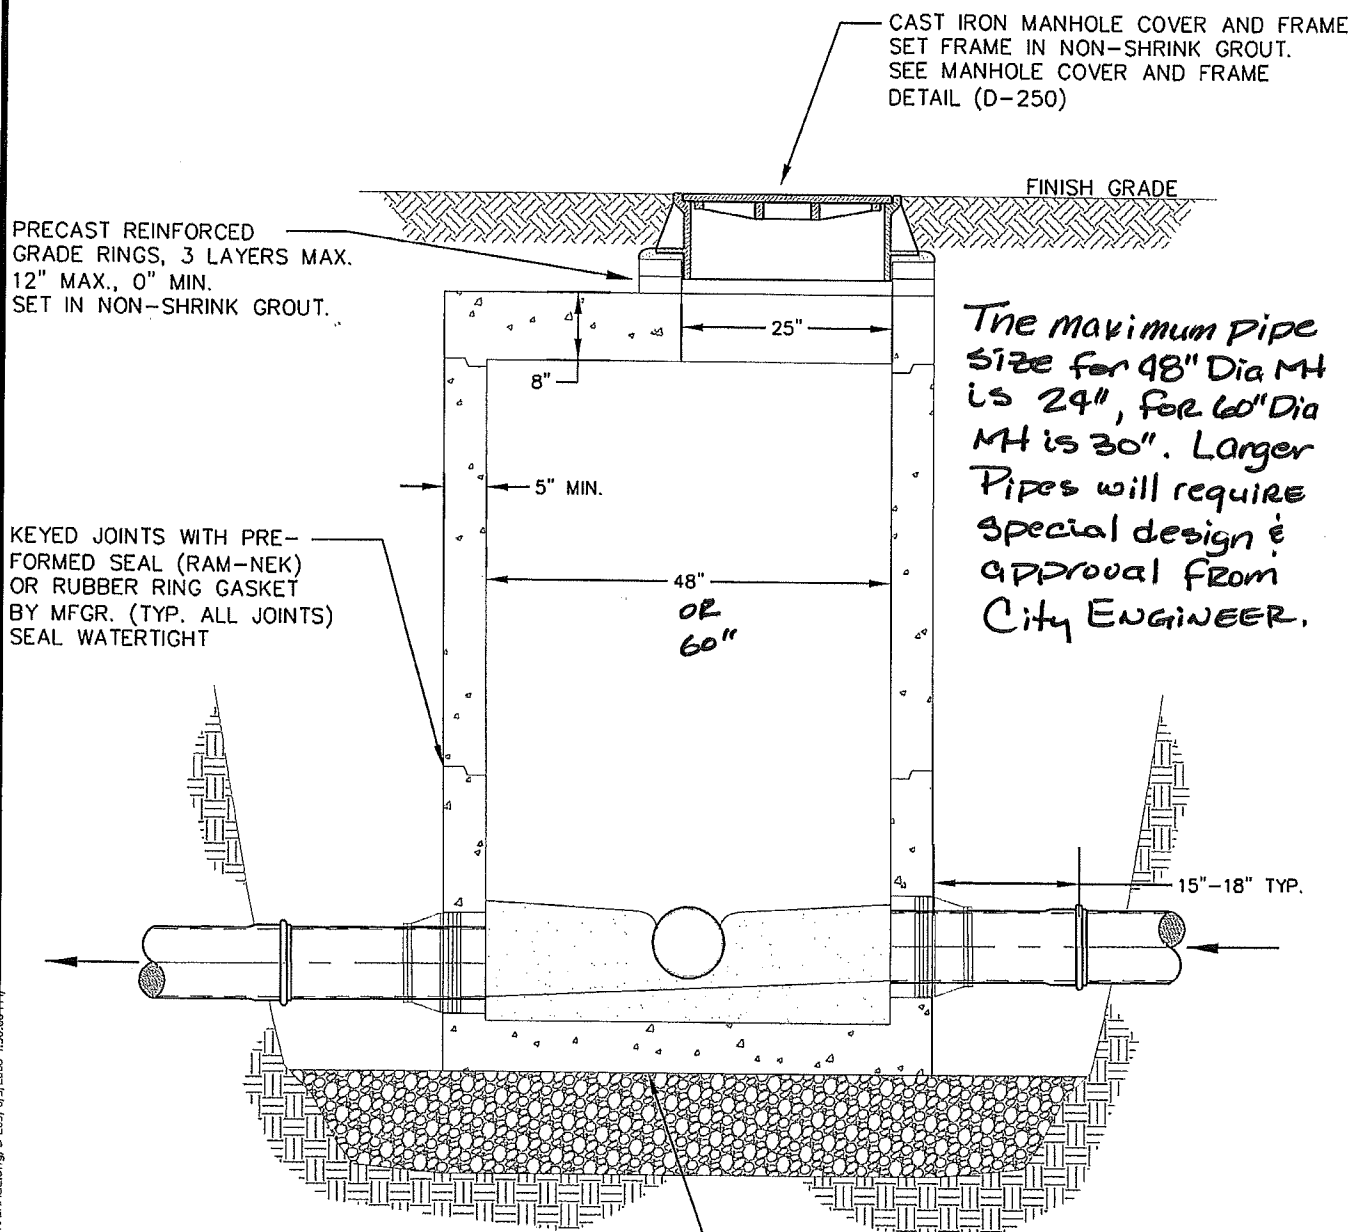

NOTE:

- 1) ALL PRECAST MANHOLE SECTIONS SHALL MEET ASTM C-478.
- 2) STANDARD MANHOLE REQUIRED WHEN DEPTH FROM FINISH GRADE TO INVERT IS 6 FEET OR MORE.



City of Coos Bay  
500 Central Ave  
Coos Bay, Oregon 97420  
541.269.8918



FLAT-TOP MANHOLE DETAIL



DETAIL NO.






AT SPRING LINE OF PIPE  
EXTEND CHANNEL UP TO  
CROWN LINE ON 12:1  
BATTER (TYP)

BENCH SLOPE  
12:1 (TYP)

FLEXIBLE RUBBER BOOT  
KOR-N-SEAL OR EQUAL  
AS APPROVED.

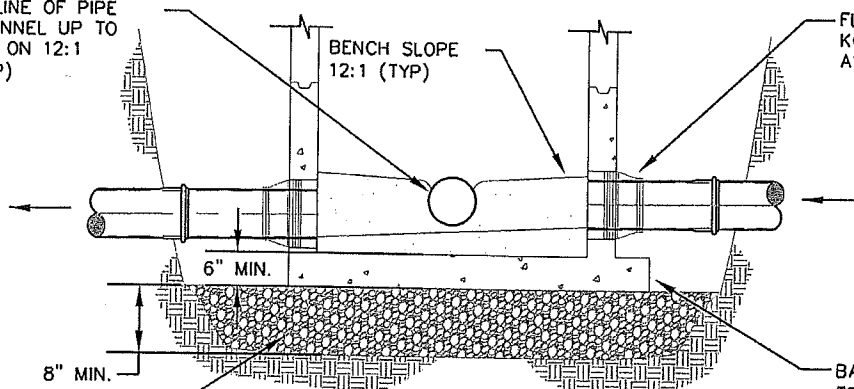

3/4"-0 CRUSHED  
ROCK BASE (TYP)

## PRECAST BASE


PRECAST BASE HEIGHT  
SUFFICIENT TO AVOID  
JOINT AT PIPE PENETRATIONS

BASE EXTENSION AS REQ'D  
TO PREVENT UPLIFT (TYP)

UNDISTURBED EARTH OR  
COMPACT SELECT MATERIAL  
AS REQ'D (95%) (TYP)

OR GREATER AS REQ'D  
TO PREVENT UPLIFT

RAM-NEK SEAL

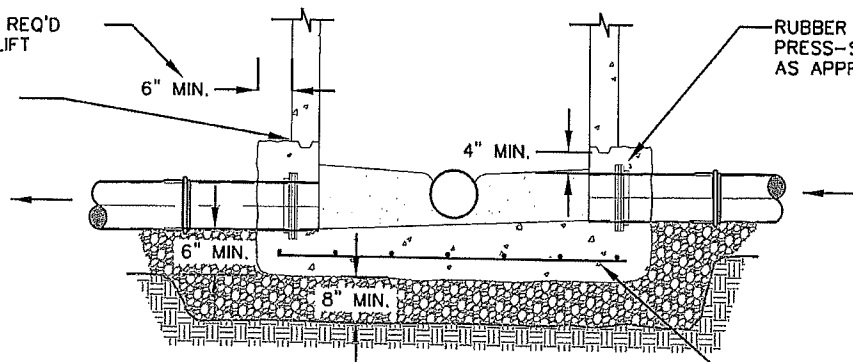


RUBBER WATERSTOP GROUT RING  
PRESS-SEAL GASKET OR EQUAL  
AS APPROVED.

#4 HOOP AND #4 @ 12" E.W.  
#5 BARS WHEN DEPTH  
EXCEEDS 15'

## CAST-IN-PLACE BASE

CONTOUR TO PROVIDE  
SMOOTH CHANNELS  
SHAPE TO AVOID SOLIDS  
DEPOSITION AND DIRECT  
HEAD-ON FLOWS

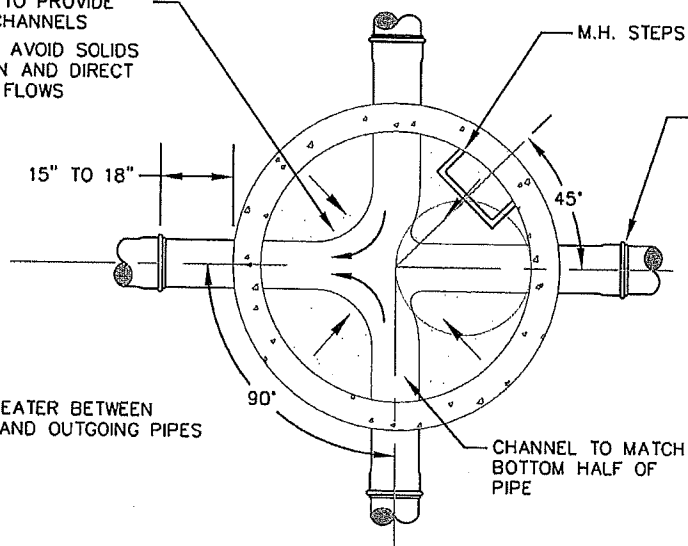

M.H. STEPS

PIPE JOINT  
FLEXIBLE COUPLING  
WHERE CONNECTING  
TO EXIST. PIPE

90' OR GREATER BETWEEN  
INCOMING AND OUTGOING PIPES

CHANNEL TO MATCH  
BOTTOM HALF OF  
PIPE

PRECAST OR CAST-IN-PLACE  
BASE AT CONTRACTOR'S  
OPTION OR AS DIRECTED.

MIN. 0.2 FT. INVERT DROP  
ACROSS INLET AND OUTLET  
PIPES.



City of Coos Bay  
500 Central Ave  
Coos Bay, Oregon 97420  
541.269.8918




## MANHOLE BASE STANDARD DETAILS


DETAIL NO.






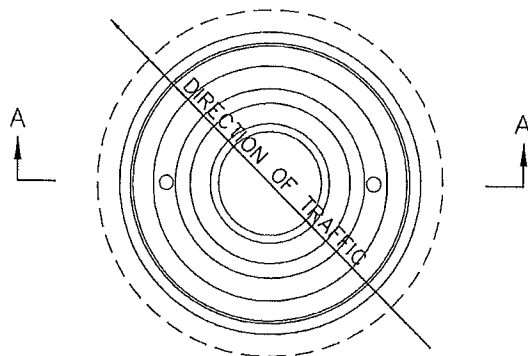


PLAN

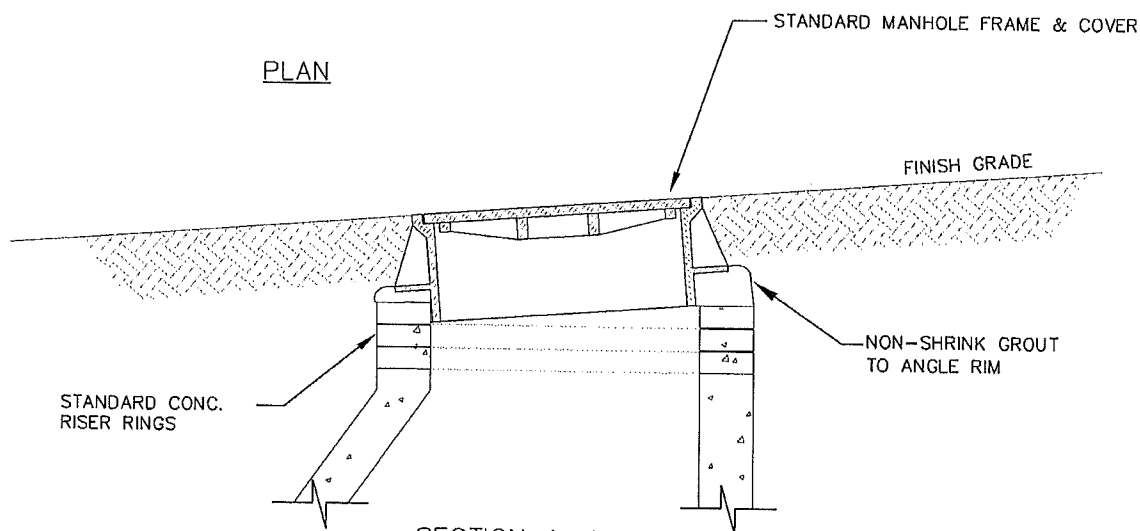

SECTION A-A  
TYPICAL MANHOLE GRADE ADJUSTMENT IN STREET

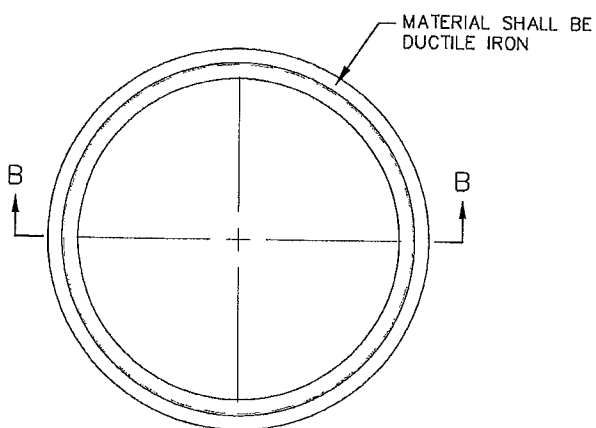

MANHOLE ADJUSTMENT RINGS  
FOR RESURFACING

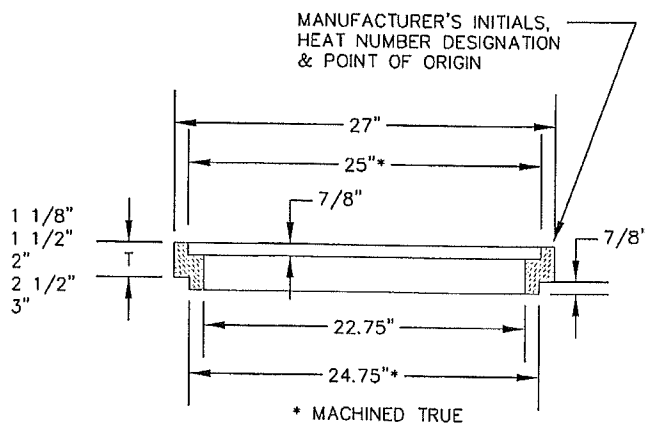

SECTION B-B

\\work\projects\Coos Bay Dev\Std\Standards\CD Sewer Standards\Details\SEWER.dwg, S-2601, 6/5/2008 4:23:12 PM, User: Coos Bay Dev\Std\Standards\CD Sewer Standards\Details\SEWER.dwg, 211



City of Coos Bay  
500 Central Ave  
Coos Bay, Oregon 97420  
541.269.8918



## MANHOLE FRAME GRADE ADJUSTMENT

DETAIL NO.


260

2008



DATE :	SCALE :
8/17/95	NONE
DRAWING NO.	APPROVED BY :
	G.KOLB

# **SINGLE/JOINT USE CASING FOR WATER & SEWER LINES**

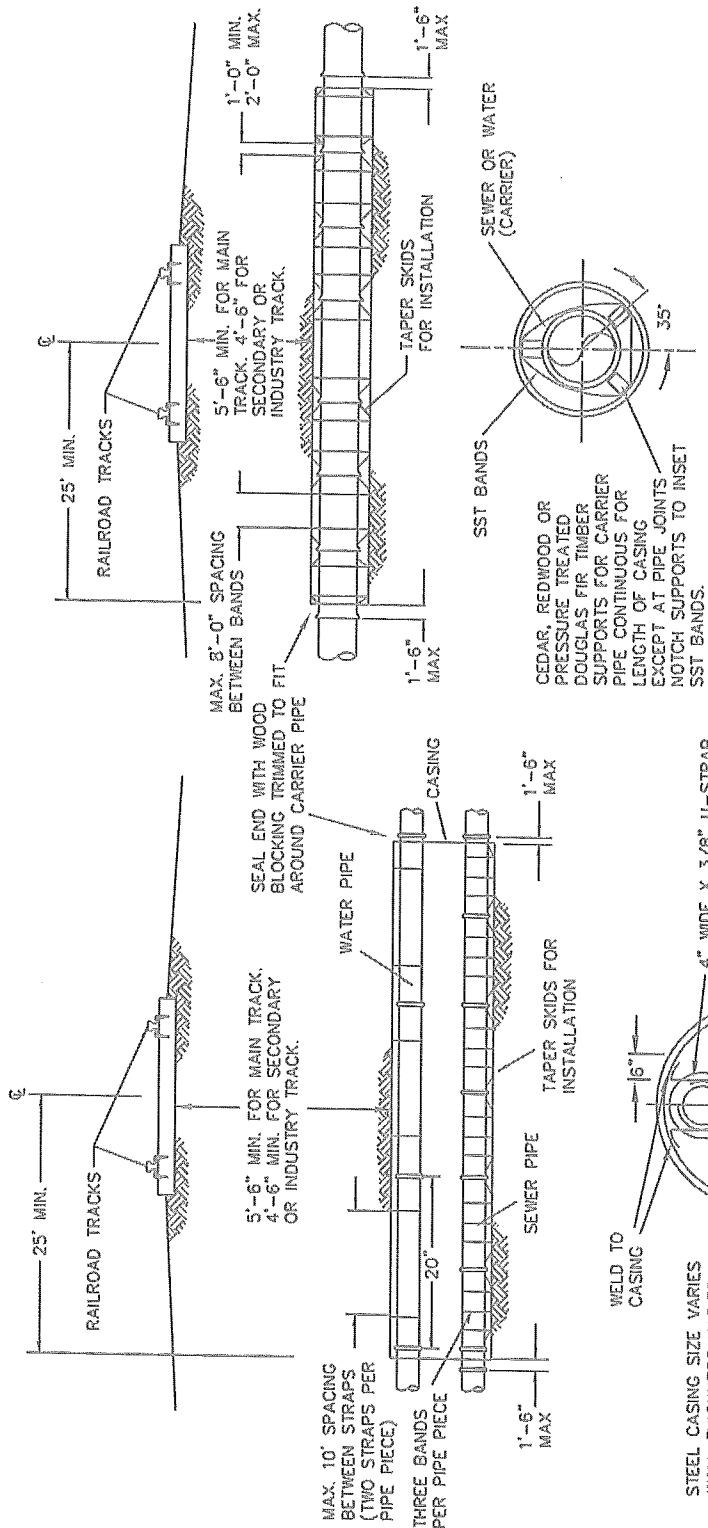

## **SINGLE USE CASING**

CASING PIPE UNDER RAILROADS MIN. STEEL YIELD STRENGTH 35,000 PSI	
PIPE DIAMETER (INCHES)	MINIMUM WALL THICKNESS (INCH)
UNDER 14	0.188
14-16	0.219
18	0.250
20	0.281
22	0.312
24	0.344
26	0.375
28-30	0.406
32	0.438
34-36	0.469
38-42	0.500
* PER AMERICAN RAILWAY ENGINEERING ASSOCIATION, E-72 LOADING	

## **JOINT USE CASING**

## **RAILROAD CROSSING DETAIL**

### **NOTES:**

1. MINIMUM CASING WALL THICKNESS VARIES WITH CASING SIZE. SEE TABLE
2. CASING SHALL CONFORM TO SEWER SLOPE WHEN APPLICABLE.
3. CROSSING DETAIL MAY BE USED FOR HIGHWAYS, STREETS, AND ROADS WITH MIN. WALL THICKNESS OF 0.25 INCH.



# STREET AND TRANSPORTATION SYSTEMS

## STANDARD DETAIL DRAWINGS INDEX

T-050: STANDARD PAVED STREET

T-051: MINIMUM STRUCTURAL STREET DESIGN

~~T-072: STANDARD UTILITY LOCATIONS~~

T-100: TYPICAL CUL-DE-SAC DETAIL

~~T-150: RESIDENTIAL DRIVEWAY APPROACH DETAIL~~

Concrete Driveway  
Approach Option "A"

~~T-151: COMMERCIAL DRIVEWAY APPROACH DETAIL~~

Concrete Driveway  
Approach Option "B"

~~T-201: PEDESTRIAN/BIKE PATH DETAIL~~

Typical Multi-Use Path

T-210: STANDARD SIDEWALK DETAILS

~~T-211: SIDEWALK AND RAMP DETAIL WITH PLANTER STRIP~~

SIDEWALK & CURB RAMPS (w/ Planter strip)

~~T-212: SIDEWALK AND RAMP DETAIL WITHOUT PLANTER STRIP~~

Sidewalk & CURB RAMPS (w/out Planter strip)

~~T-213: RAMP AND TEXTURE DETAIL WITH PLANTER STRIP~~

~~T-214: RAMP AND TEXTURE DETAIL WITHOUT PLANTER STRIP~~

T-301: CURB AND GUTTER DETAIL

T-302: VALLEY GUTTER DETAIL

T-401: STANDARD STREET LIGHT DETAIL

~~T-450: STANDARD SIGN DETAIL~~ Typical Stop & Street Name Sign  
Combination

T-451: STREET SIGN AND LETTERING DETAILS

T-501: STANDARD PERMANENT BARRICADE DETAIL

Cluster Postal Delivery Box Parking Bay  
"T" INTERSECTION Alignment Standard.



City of Coos Bay  
500 Central Ave  
Coos Bay, Oregon 97420  
541.269.8918



STANDARD DETAIL  
DRAWING INDEX

DETAIL NO.

010

JAN 2008






City of Coos Bay  
500 Central Ave  
Coos Bay, Oregon 97420  
541.269.8918

## STANDARD PAVED STREET

DETAIL NO.

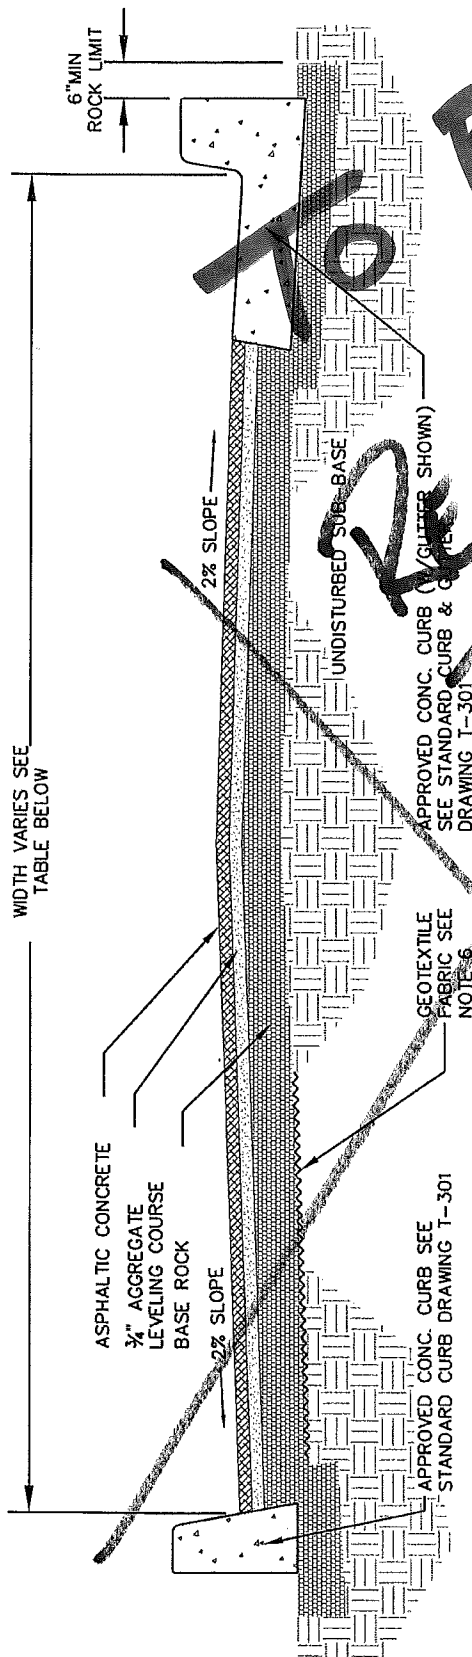

### NOTES:

- 1) REFERENCE CITY OF COOS BAY LAND DEVELOPMENT ORDINANCE
- 2) STREETS SHALL BE PAVED CENTERED IN THE PUBLIC RIGHT OF WAY
- 3) DEVELOPER SHALL OBTAIN WRITTEN APPROVAL TO PAVE OVER PUBLIC UTILITIES FROM COOS BAY/NORTH BEND WATER BOARD, PACIFIC POWER & LIGHT, VENTURA TELEPHONE, COMCAST CABLE, NORTH WEST NATURAL, AND THE CITY OF COOS BAY.
- 4) THE DEVELOPER SHALL OBTAIN A RIGHT OF WAY USE PERMIT AND SUBMIT A COMPLETE SET OF ENGINEERED DRAWINGS SHOWING THE PLAN AND PROFILE VIEWS OF EXISTING CONDITIONS AND PROPOSED WORK. WHEN PROJECT IS COMPLETE, THE DEVELOPER SHALL FURNISH THE CITY WITH A COMPLETE SET OF REPRODUCIBLE DRAWINGS AND CD SHOWING THE "AS CONSTRUCTED" CONDITIONS OF THE COMPLETED PROJECT.
- 5) SEE DESIGN STANDARDS MANUAL FOR COMPACTION OF MATERIALS AND TESTING.
- 6) GEOTEXTILE FABRIC AS REQ'D

MIN. WIDTH  
CURB-TO -CURB


STREET TYPE	MIN. WIDTH CURB-TO -CURB
ARTERIAL	72'-74'
1-LANE	48'-50'
2-LANE	34'-36'
COLLECTOR	50'-52'
LOCAL	36'
RESIDENTIAL	40'
COMMERCIAL/INDUSTRIAL	36'
ROAD END	45' RAD
CORNER SAC	20'
ALLEY	20'

\* WIDTHS MAY BE MODIFIED BY THE CITY ENGINEERING DEPARTMENT TO SUIT SITE CONDITIONS


**TO BE REVISED TO REFLECT TABLE 1.31 OF Design Stds.**




ARTERIAL  
STANDARD CURB & GUTTER WITH SIDEWALKS  
36'-74' WIDE

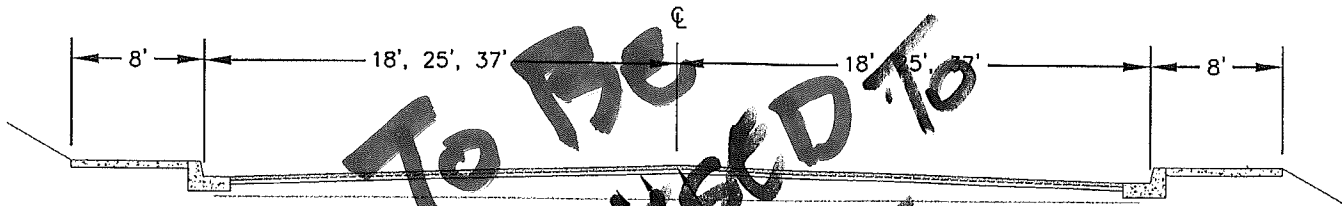


COLLECTOR STREETS  
STANDARD CURB & GUTTER WITH SIDEWALKS  
50'-52' WIDE

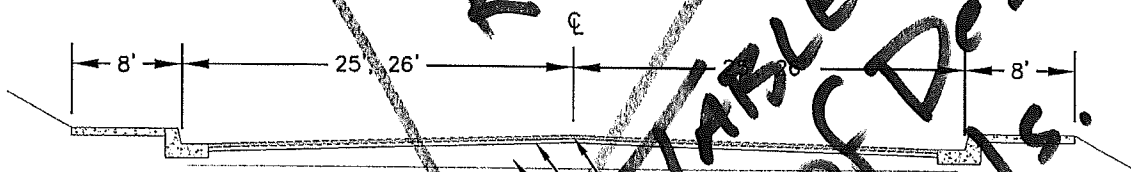

LOCAL STREET OR DEAD END  
STANDARD CURB & GUTTER WITH SIDEWALKS  
36' WIDE

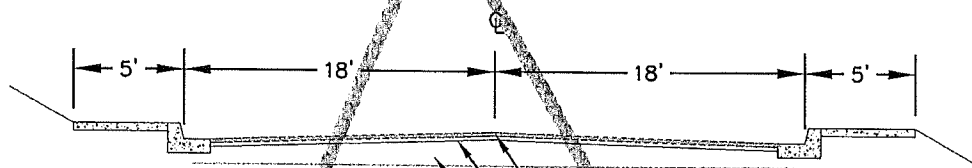

ALLEY  
STRIP PAVEMENT WITH VALLEY AND GUTTER  
20' WIDE

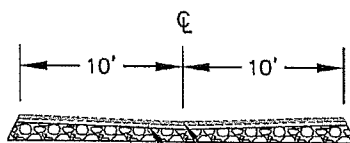

NOTES:

1. APPROVED SIDEWALKS SEE STANDARD SIDEWALK DETAIL T-210
2. APPROVED CONCRETE CURB & GUTTER SEE STANDARD CURB & GUTTER DETAIL T-301

4" ASPHALTIC CONCRETE

2" 3/4"-0 AGGREGATE LEVELING COURSE

8" 1 1/2"-0 AGGREGATE BASE COURSE

4" ASPHALTIC CONCRETE

2" 3/4"-0 AGGREGATE LEVELING COURSE

8" 1 1/2"-0 AGGREGATE BASE COURSE

2" ASPHALTIC CONCRETE

2" 3/4"-0 AGGREGATE LEVELING COURSE

8" 1 1/2"-0 AGGREGATE BASE COURSE

2" ASPHALTIC CONCRETE

2" 3/4"-0 AGGREGATE LEVELING COURSE

8" 1 1/2"-0 AGGREGATE BASE COURSE



City of Coos Bay  
500 Central Ave  
Coos Bay, Oregon 97420  
541.269.8918

MINIMUM STRUCTURAL  
STREET DESIGN STANDARDS

DETAIL NO.





RIGHT-OF-WAY  
BACK OF SIDEWALK

CURB & GUTTER

25' MIN. RADIUS  
(TYPICAL)

*VARIES*  
*30'*

*VARIES*  
*20'*

5'

5'

NOTES:

1. CUL-DE-SAC GEOMETRY SHOWN DOES NOT ALLOW FOR ON-STREET PARKING. IF ON-STREET PARKING IS DESIRED, THE RADIUS TO THE FACE OF CURB MUST BE INCREASED TO ACCOUNT FOR A SINGLE PARKING LANE WIDTH. (MINIMUM 8 FEET)



City of Coos Bay  
500 Central Ave  
Coos Bay, Oregon 97420  
541.269.8918




TYPICAL CUL-DE-SAC DETAIL

DETAIL NO.






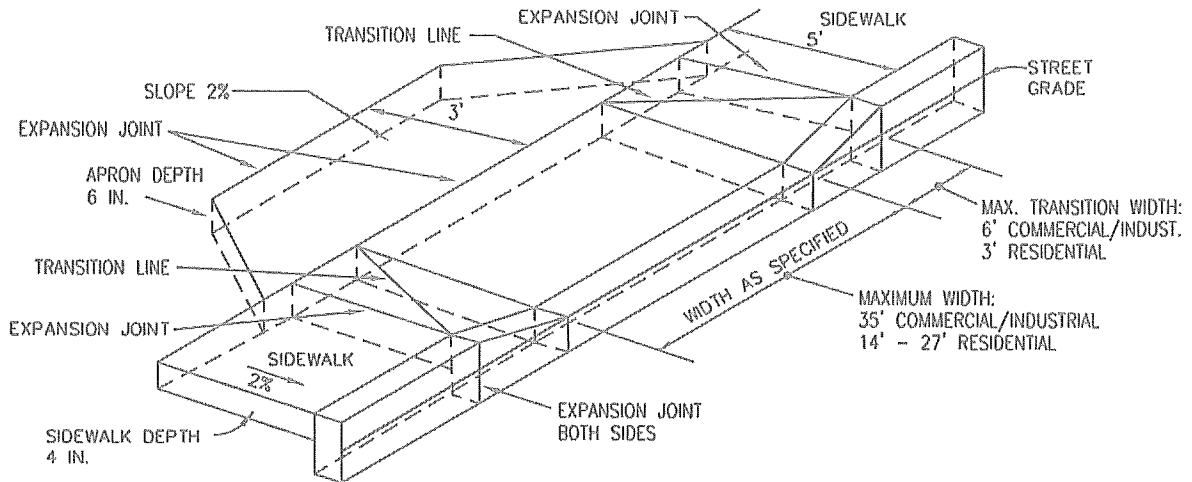


TYPICAL DRIVEWAY / DROP CURB FOR STANDARD SIDEWALK - OPTION "A"

N.T.S.

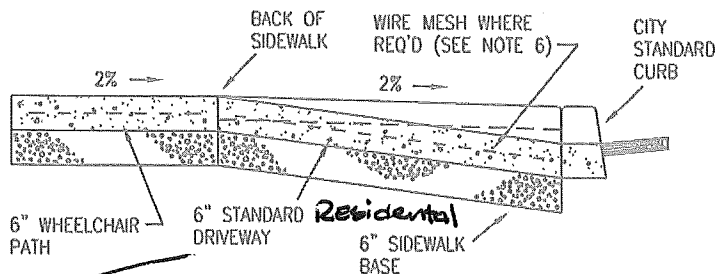


TYPICAL DRIVEWAY SECTION

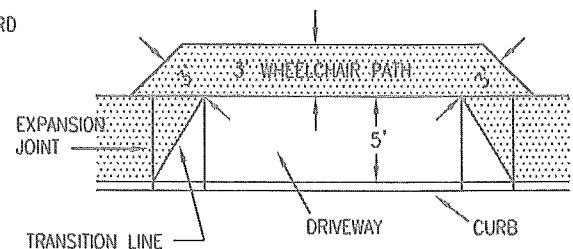


PLAN VIEW

N.T.S.

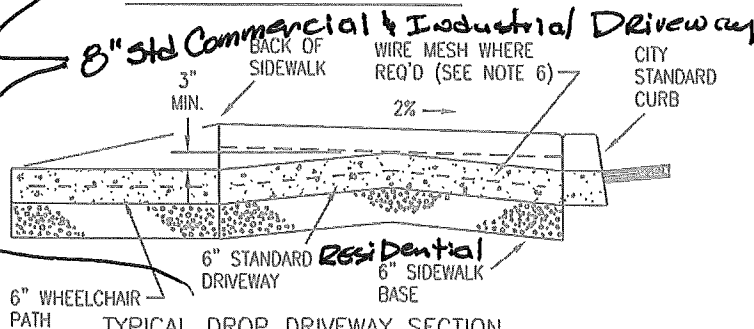

TYPICAL DROP DRIVEWAY SECTION

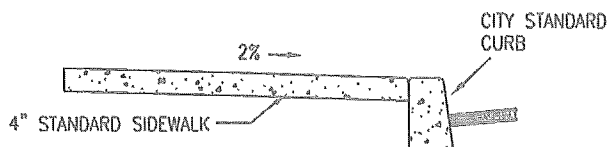


TYPICAL SIDEWALK SECTION (SEE DWG. [REDACTED])

#### NOTES:


1. COMPACT BACKFILL UNDER SIDEWALK & DRIVEWAY TO 90% OF RELATIVE MAXIMUM DENSITY (AASHTO T-99) TO 6" THICK MIN.
2. CONCRETE SHALL BE 6.0 SACK, CLASS 3000 AND CONTAIN NO ADDITIVES TO CAUSE RAPID SETTING. 4% - 7% ENTRAINED AIR REQUIRED. PROTECT FROM ADVERSE WEATHER FOR 7 DAYS MIN.
3. LIGHT TRANSVERSE BROOM FINISH REQUIRED ON SIDEWALKS AND DRIVEWAYS.
4. FULL EXPANSION JOINTS AT ENDS OF DRIVEWAY. CONTRACTION JOINTS AT CENTER OF DRIVEWAY AND 5' CENTERS ALONG SIDEWALK.
5. MAINTAIN CONSTANT GRADE AT BACK EDGE THROUGH DRIVEWAYS WHENEVER POSSIBLE.
6. NO. 4 REBAR (2 LONGITUDINAL BARS, TRANSVERSE BARS 4'-0" O.C.) REQUIRED IN COMMERCIAL AND INDUSTRIAL DRIVEWAYS. 6" x 6", 10 GA., WIRE MESH MAY BE USED IN LIEU OF REBAR.
7. DRIVEWAY APRONS ARE REQUIRED ON ALL NEW CONSTRUCTION.

DATE :	SCALE :	CONCRETE DRIVEWAY [REDACTED] OPTION "A"
1/3/97	NONE	
DRAWING NO.	APPROVED BY :	
[REDACTED]	G.KOLB	

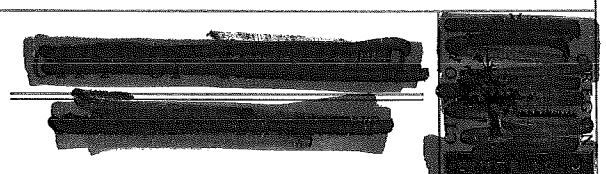




STREET GRADE	A
0.5% TO 1%	4'
1% TO 3.5%	6'
3.5% & UP	8'

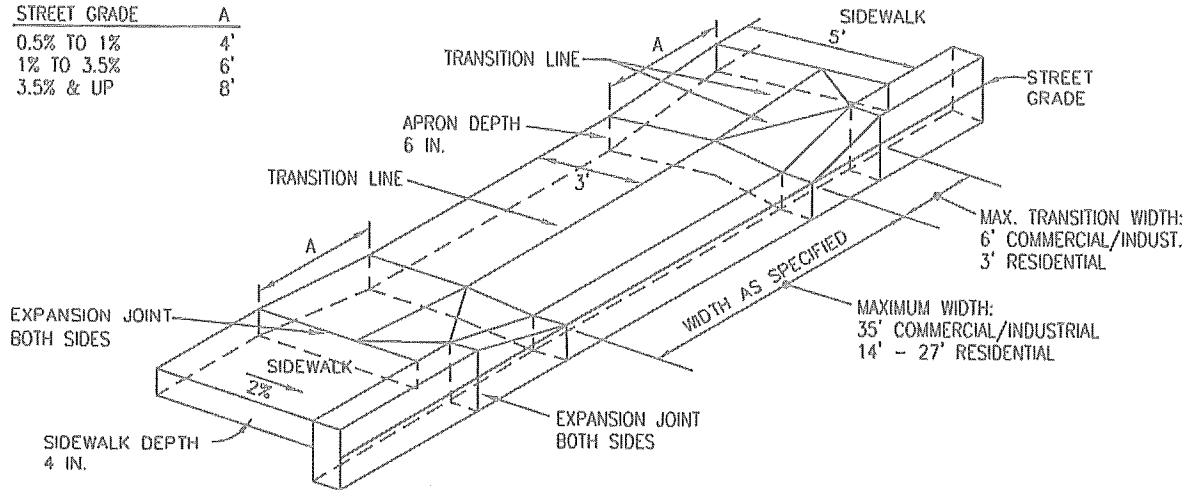


TYPICAL DRIVEWAY / DROP CURB FOR STANDARD SIDEWALK - OPTION "B"

N.T.S.

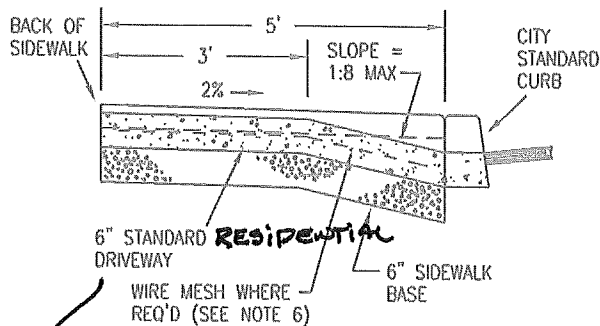


TYPICAL DRIVEWAY SECTION

8" STD Commercial & Industrial Driveway

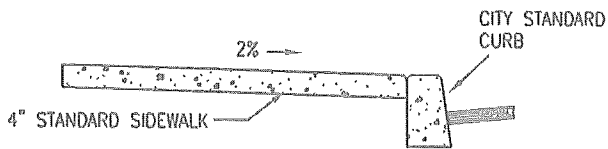

TYPICAL SIDEWALK SECTION (SEE DWG [REDACTED])

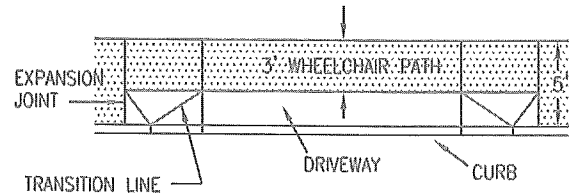


PLAN VIEW

N.T.S.


#### NOTES:

1. COMPACT BACKFILL UNDER SIDEWALK & DRIVEWAY TO 90% OF RELATIVE MAXIMUM DENSITY (AASHTO T-99) TO 6" THICK MIN.
2. CONCRETE SHALL BE 6.0 SACK, CLASS 3000 AND CONTAIN NO ADDITIVES TO CAUSE RAPID SETTING. 4% - 7% ENTRAINED AIR REQUIRED. PROTECT FROM ADVERSE WEATHER FOR 7 DAYS MIN.
3. LIGHT TRANSVERSE BROOM FINISH REQUIRED ON SIDEWALKS AND DRIVEWAYS.
4. FULL EXPANSION JOINTS AT ENDS OF DRIVEWAY. CONTRACTION JOINTS AT CENTER OF DRIVEWAY AND 5' CENTERS ALONG SIDEWALK.
5. MAINTAIN CONSTANT GRADE AT BACK EDGE THROUGH DRIVEWAYS WHENEVER POSSIBLE.
6. NO. 4 REBAR (2 LONGITUDINAL BARS, TRANSVERSE BARS 4'-0" O.C.) REQUIRED IN COMMERCIAL AND INDUSTRIAL DRIVEWAYS. 6"x 6", 10 GA., WIRE MESH MAY BE USED IN LIEU OF REBAR.
7. DRIVEWAY APRONS ARE REQUIRED ON ALL NEW CONSTRUCTION.

DATE :	SCALE :	CONCRETE DRIVEWAY [REDACTED] OPTION "B"
1/3/97	NONE	
DRAWING NO.	APPROVED BY :	
[REDACTED]	G.KOLB	

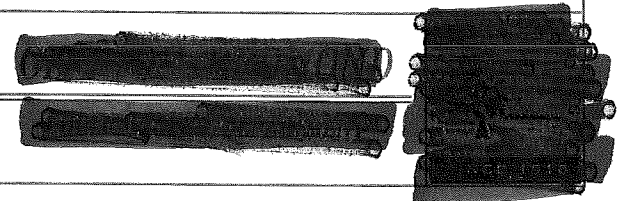



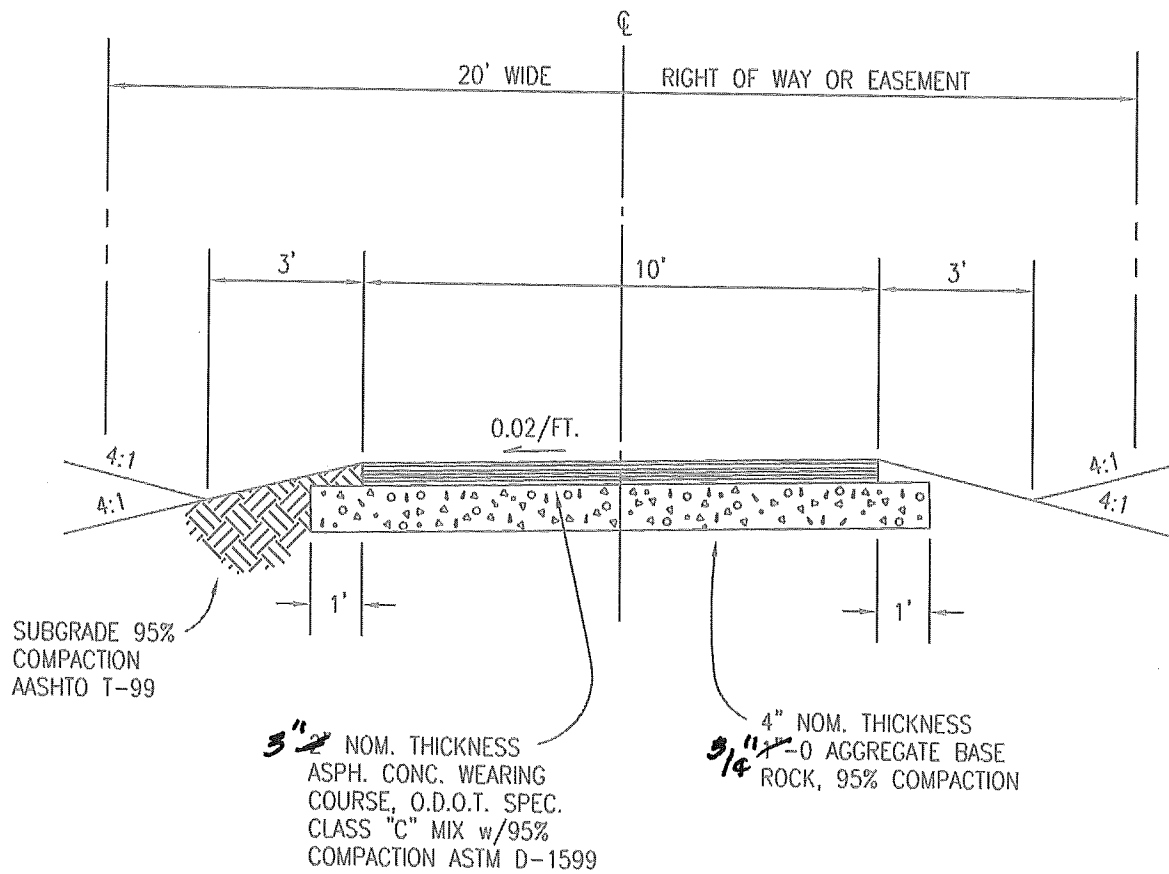

4" Portland Concrete  
meeting the Requirement  
of Section 00440 - Comm.  
GRADE Concrete

NOTE:

PLACE 6" OF SELECT BACKFILL  
ON ALL SLOPES TO CATCH POINT  
PRIOR TO PAVING

DATE :	SCALE :	TYPICAL MULTI-USE PATH SECTION	[REDACTED]
6/30/95	NONE		
DRAWING NO.	APPROVED BY :	[REDACTED]	[REDACTED]
[REDACTED]	G.KOLB		






# Concrete per City of Coos Bay Standard Specification Section XX.

## Concrete Pavement

### NOTES:


- 1) ~~Concrete per City of Coos Bay Standard Specification Section XX.~~  
~~Concrete per City of Coos Bay Standard Specification Section XX.~~
- 2) STANDARD SIDEWALK CROSS SLOPE SHALL BE 2%. WHEN THE LOT IS BELOW THE TOP OF THE CURB AND SLOPE DOWN FROM CURB, A MINUS 2% SLOPE MAY BE REQUIRED
- 3) CONCRETE DEPTH FOR SIDEWALKS SHALL BE A NOMINAL 4" MIN. DRIVEWAY SECTIONS INCLUDING SIDEWALKS THROUGH DRIVEWAYS SHALL BE NOMINAL 6" MIN FOR LOCAL STREETS AND 8" FOR ARTERIALS AND COLLECTORS  
*Residential approaches*  
*Commercial approaches*  
*Industrial approaches*
- 4) CONTRACTION JOINTS SHALL BE INSTALLED AT APPROXIMATE INTERVALS OF 15' BY CUTTING AT LEAST  $\frac{1}{3}$  OF THE DEPTH OF THE CONCRETE. "DUMMY" JOINTS SHALL BE INSTALLED AT APPROXIMATE INTERVALS OF 5'. EXPANSION JOINTS WITH PREMOLDED FILLER SHALL BE INSTALLED BETWEEN DRIVEWAYS & SIDEWALKS AT THE DIRECTION OF THE ENGINEER, SEE DRIVEWAY STANDARD
- 5) INSTALL A BOND BREAKER OR ISOLATION JOINT BETWEEN BACK OF CURB & SIDEWALK, & AROUND ANY OBSTRUCTION WITHIN SIDEWALK AREA
- 6) DRAIN BLOCKOUTS IN THE CURB SHALL BE EXTENDED TO THE BACK OF THE SIDEWALK WITH A 3" DIA. PLASTIC PIPE AT A 2% SLOPE. A CONTRACTION JOINT SHALL BE PLACED OVER THE PIPE
- 7) SEE STANDARD WHEELCHAIR/BICYCLE RAMP DETAILS FOR SIDEWALK PATTERNS AT INTERSECTION CURB RETURNS
- 8) SEE, ALSO, STANDARD DETAILS FOR DRIVEWAYS, ~~T-150, T-151~~
- 9) A MIN. SEPARATION OF 4' BETWEEN CURB & SIDEWALK IS RECOMMENDED FOR LANDSCAPE MAINTENANCE
- 10) SIDEWALKS 8' AND WIDER SHALL HAVE A LONGITUDINAL CONTRACTION JOINT AT THE MIDPOINT

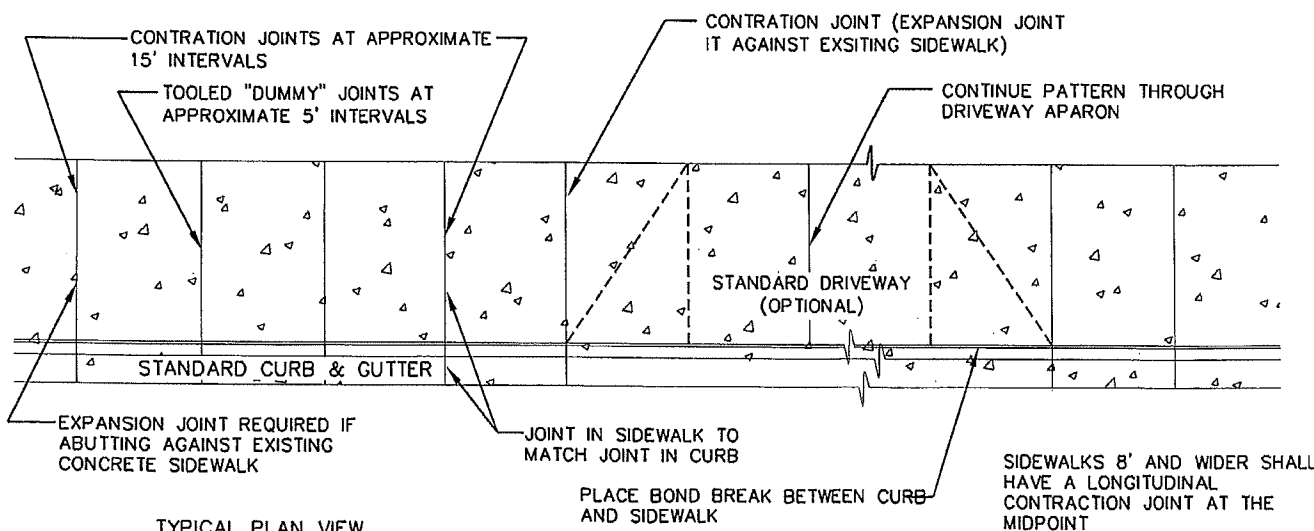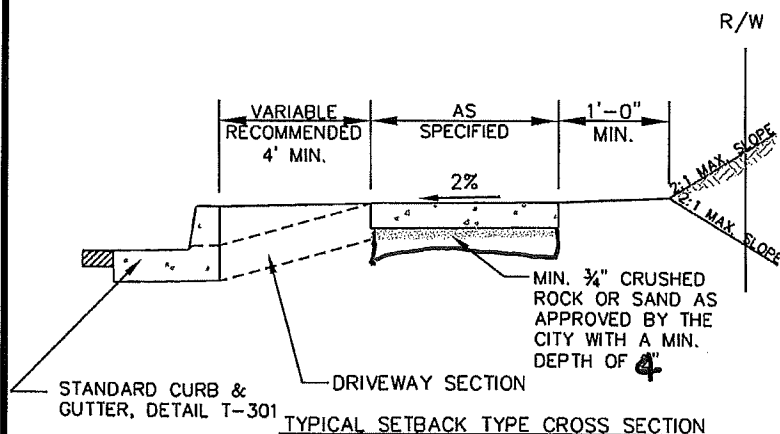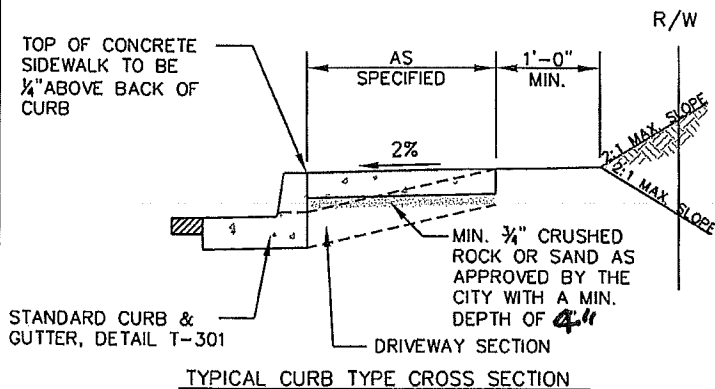

TYPICAL PLAN VIEW



City of Coos Bay  
500 Central Ave  
Coos Bay, Oregon 97420  
541.269.8918

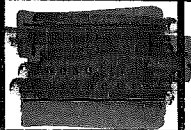




## STANDARD SIDEWALK DETAILS

DETAIL NO.







THESE REQUIREMENTS BASED ON OREGON STATE HIGHWAY DIVISION DWG. NO. RD725, 1/96

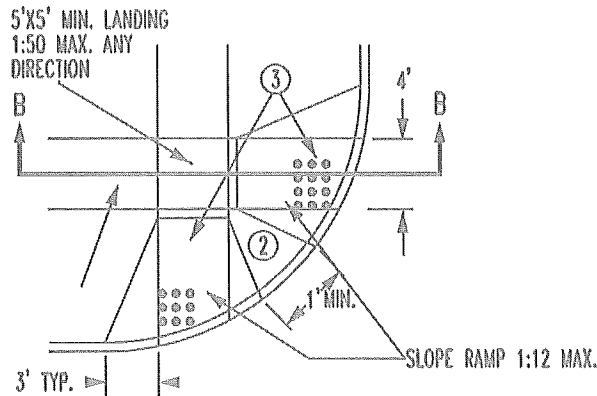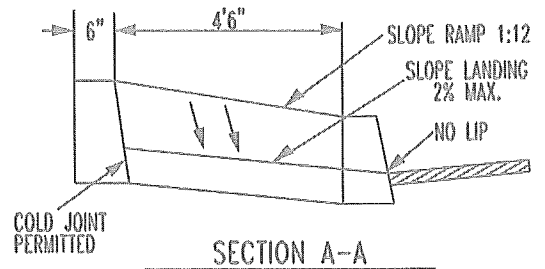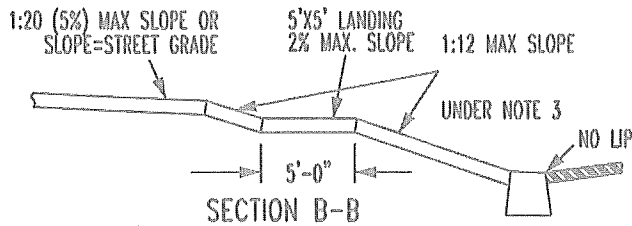

PERPENDICULAR RAMP  
STANDARD FOR NEW CONSTRUCTION  
(SHOWN ON 15' RADIUS)

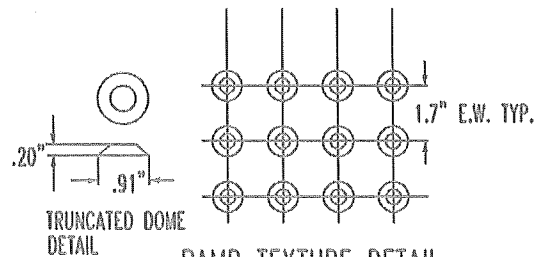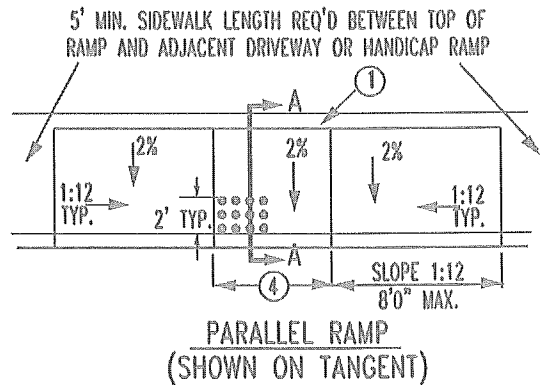

RAMP TEXTURE DETAIL

1. PLACE TRUNCATED DOMES AS O.D.O.T. DETAIL DWG. NO. RD255
2. TEXTURE TO BE APPLIED TO LOWER 2' OF RAMP

NOTE:


1. BACK EDGE OF RAMP IMPROVEMENT TO BE THE SAME PROFILE AND GRADE AS THE CONTINUATION OF THE BACK EDGE OF SIDEWALK THROUGH THE RAMP AREA.
2. THIS AREA IS NOT A SIDEWALK AND IS CONCRETE SURFACED ONLY FOR MAINTENANCE PURPOSES. WHERE THIS AREA EXCEEDS 100 SF, OR IS DESIGNED FOR LANDSCAPING IN AN APPROVED SITE PLAN, IT MAY BE LEFT OPEN.
3. IN ALTERATIONS CURB RAMP SLOPE(S) MAY BE 10% FOR A MAX. RISE OF 6" OR 12.5% FOR A MAX. RISE OF 3". CURB RAMPS, IN ALTERATIONS NEED NOT EXCEED 6' IN LENGTH. [O.D.O.T. DWG. NO. RD255]
4. 5'-0" MIN. NEW CONSTRUCTION; 4'-0" MIN. ALTERATIONS; SIDE FLARES: SEE NOTE 6, [ODOT DWG. NO. RD725] - NO GRATING IS TO BE SPECIFIED AT THE BOTTOM OF RAMP - RAMPS FOR BIKEWAYS TO BE A SEPARATE DESIGN CONFORMING TO BIKEWAY STANDARDS.

DATE :	SCALE :	SIDEWALK & CURB RAMPS	[REDACTED]
4/22/03	NONE		
DRAWING NO.	APPROVED BY :	[REDACTED]	[REDACTED]
[REDACTED]	JSE		





THESE REQUIREMENTS BASED ON OREGON STATE HIGHWAY DIVISION DWG. NO. RD725, 1/96

RAMP SHOWN ON  
15' RADIUS

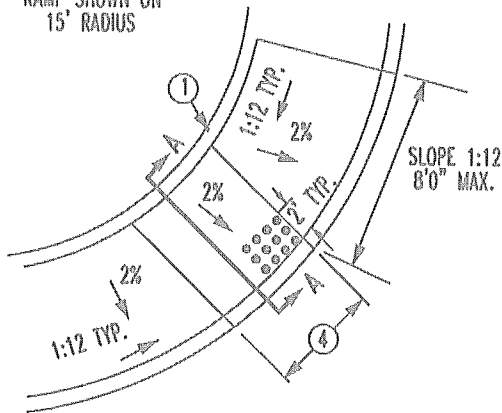

### PARALLEL RAMP ON CURB RADIUS CENTER

A RAMP-ON-RADIUS WILL BE PERMITTED ONLY AT CITY ENGINEERS DISCRETION

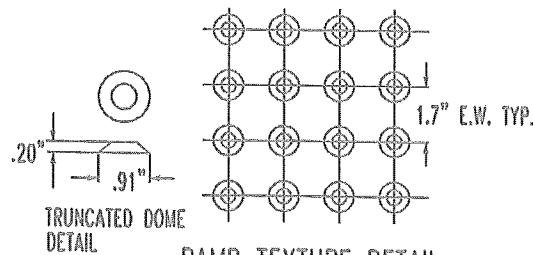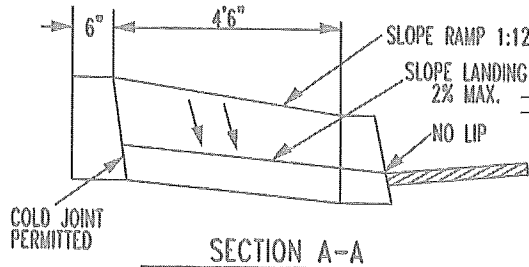

1. PLACE TRUNCATED DOMES AS PER O.D.O.T. DETAIL DWG. NO. RD725.
2. TEXTURE TO BE APPLIED TO LOWER 2' OF RAMP.

### PERPENDICULAR RAMP STANDARD FOR NEW CURB TIGHT CONSTRUCTION

#### NOTES


1. BACK EDGE OF RAMP IMPROVEMENT TO BE AT THE SAME PROFILE AND GRADE AS THE CONTINUATION OF THE BACK EDGE OF THE SIDEWALK THROUGH THE RAMP AREA.
2. IN ALTERATIONS CURB RAMP SLOPE(S) MAY BE 10% FOR A MAX. RISE OF 6" OR 12.5% FOR A MAX. RISE OF 3". CURB RAMPS, IN ALTERATIONS NEED NOT EXCEED 6' IN LENGTH. [ODOT DWG. NO. RD725]
3. 5'-0" MIN. NEW CONSTR.; 4'-0" MIN. ALTERATIONS  
-SIDE FLARES: SEE NOTE 6, [ODOT DWG. NO. RD725]  
-NO GRATING IS TO BE SPECIFIED AT THE BOTTOM OF RAMP  
-RAMPS FOR BIKEWAYS TO BE A SEPARATE DESIGN CONFORMING TO BIKEWAY STANDARDS.

DATE :	SCALE :	SIDEWALK & CURB RAMPS	
4/22/03	NONE		
DRAWING NO.	APPROVED BY :		
	JSE		




WEEPHOLES SHALL BE EXTENDED TO BACK OF WALK WHEN SIDEWALKS ARE CONSTRUCTED

DRAINAGE BLOCKOUT 3" I.D. PVC PIPE TO EXTEND OUTSIDE OF WALK OR CURB

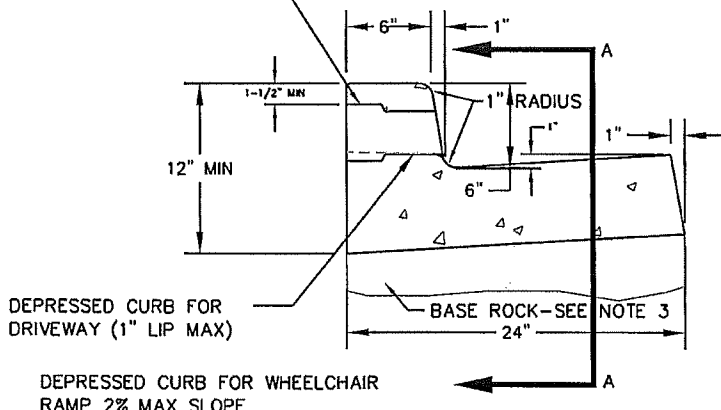


TYPICAL INTEGRAL CURB & GUTTER  
NOT TO SCALE


WEEPHOLES ARE TO BE CONSTRUCTED USING 3" ID DRAIN PIPE & COUPLING. PLACE WEEPHOLES AT EXPANSION JOINTS WHENEVER POSSIBLE

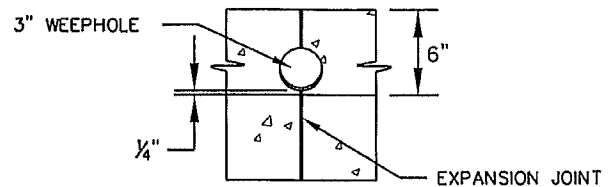

SECTION AA: WEEPHOLES  
NOT TO SCALE

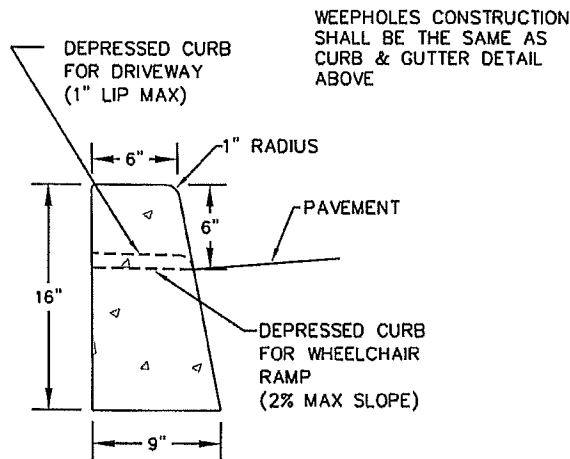

TYPICAL STRAIGHT CURB (TYPE C)  
NOT TO SCALE

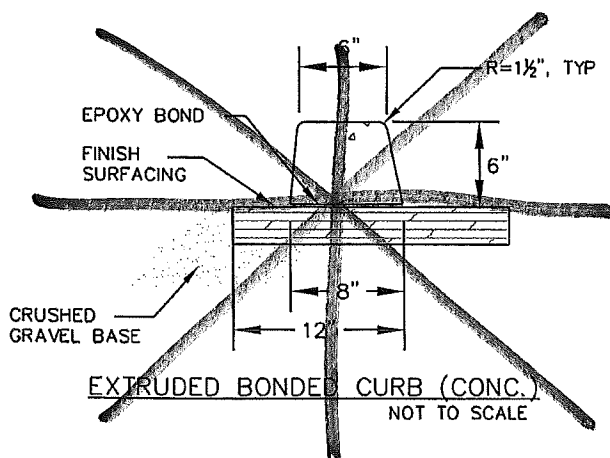


NOTES:

1. *Concrete*  
*DOT Std Spec. Section 00400 -*  
*Commercial*  
*Grade Concrete*
2. CONTRACTION JOINTS
  - A) TO BE PROVIDED
    - AT EACH POINT OF TANGENCY
    - AT EACH COLD JOINT
    - AT EACH SIDE OF INLET STRUCTURES
    - AT BOTH SIDES OF AN APPROACH *10*
  - B) SPACING TO BE NOT MORE THAN *10* FEET
  - C) THE DEPTH OF THE JOINT SHALL BE AT LEAST 1/3 OF THE THICKNESS OF CONCRETE
  - D) EXPANSION JOINTS IN CURB & GUTTER SHALL BE PLACED AT MAX *15* INTERVALS IN *15* MULTIPLES *50* *10*
3. BASE ROCK - 1-1/2"-0", 95% COMPACTION ROCK SHALL BE TO SUBGRADE OF THE STREET SECTION OR 4" IN DEPTH, WHICHEVER IS GREATER
4. DRAINAGE BLOCK - 3" DIA. PLASTIC PIPE
  - A) DRAINAGE ACCESS THROUGH EXISTING CURBS SHALL BE DONE BY:
    - CORE DRILLING, OR
    - VERTICAL SAWCUT OF CURB 18" EACH SIDE OF DRAIN AND RE-POURED TO FULL DEPTH OF CURB
5. STAMP TOP OF CURB WITH "W" AT WATER SERVICE CROSSING AND "S" AT SANITARY LATERAL CROSSING AS SPECIFIED
- ~~6. EXTRUDED BONDED CURBS SHALL NOT BE USED IN PUBLIC RIGHT OF WAYS OR PRIVATE STREET~~
7. SEE STANDARD CURB CUT DETAIL FOR DRIVEWAY
8. TYPICAL STRAIGHT CURB (TYPE C) ALLOWED FOR REPLACEMENT OF EXISTING TYPE C CURBS AND NOT RECOMMENDED FOR NEW CONSTRUCTION



City of Coos Bay  
500 Central Ave  
Coos Bay, Oregon 97420  
541.269.8918

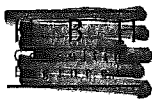


## CURB AND GUTTER DETAILS

DETAIL NO.

307




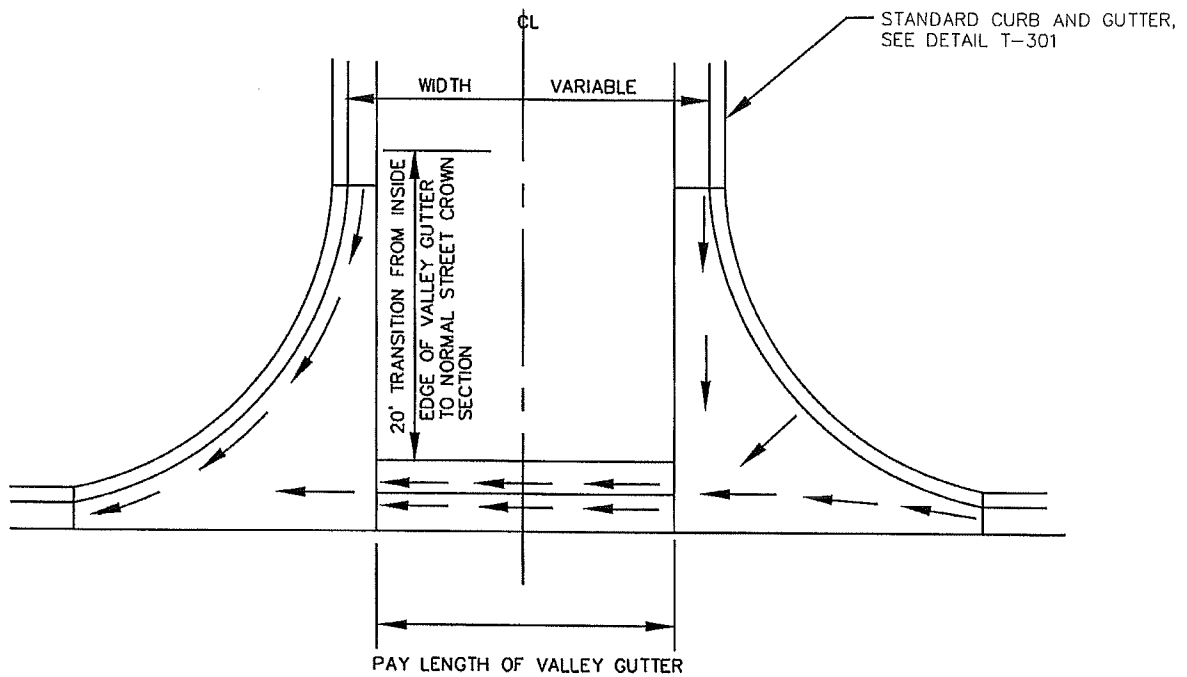

3 - #4 REBAR CONTINUOUS, REBAR SHOULD BE CENTERED IN VALLEY GUTTER

EXIST'G CONCRETE OR AC ROADWAY, TYP APPROXIMATE DEPTH = 6"

UNDISTURBED SOIL, TYP

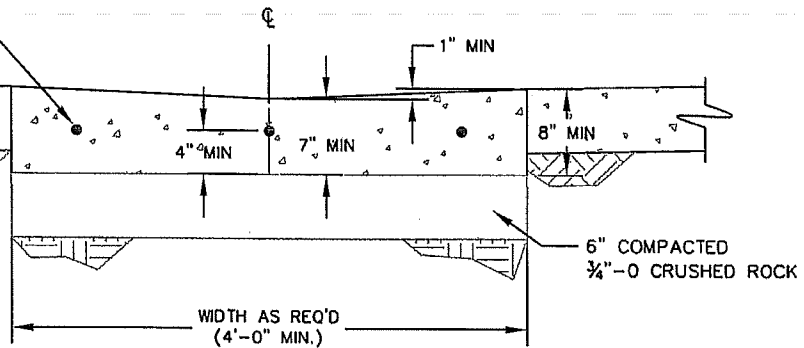

NOTE:

- 1) VALLEY GUTTERS ARE NOT TO BE USED EXCEPT FOR IN ALLEYS OR OTHER SPECIAL CONDITIONS AS APPROVED BY CITY ENGINEER.

~~2) CONCRETE VALLEY GUTTERS SHALL BE 200T CLASS 7500 CONCRETE~~



City of Coos Bay  
500 Central Ave  
Coos Bay, Oregon 97420  
541.269.8918




# VALLEY GUTTER DETAIL

DETAIL NO.






To be determined

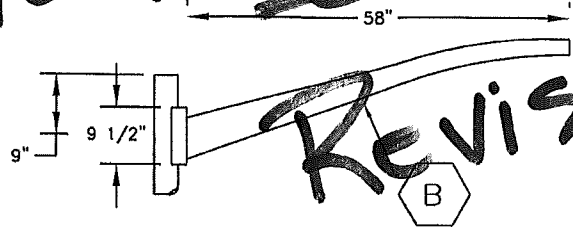

REVISED

MAST ARM MATERIAL - ALUMINUM

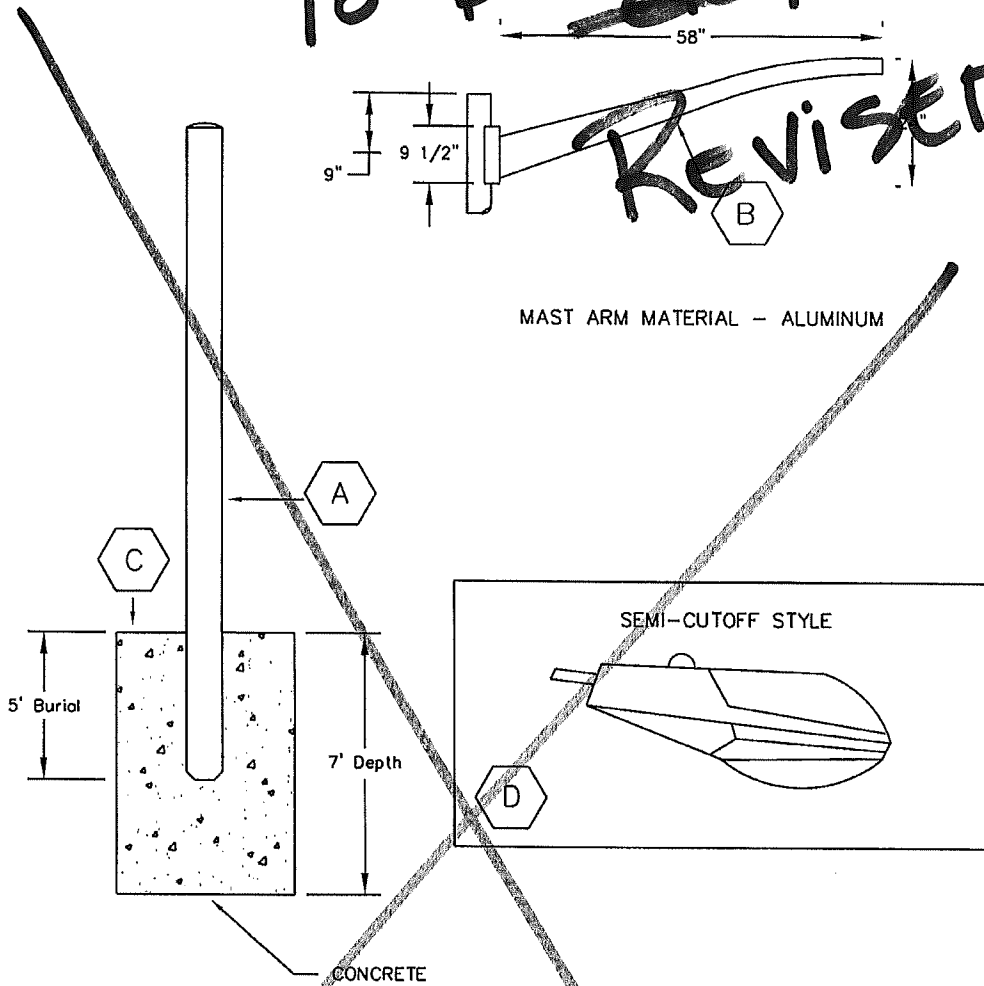

ITEM	DESCRIPTION
A	25' GRAY METAL POLE
B	5' ALUMINUM MAST ARM
C	CONCRETE
D	100 W HPS ROADWAY LAMP (WILL VARY DEPENDING ON LIGHTING REQUIREMENT)

NOTE:  
MOUNTING OF POLE AND LIGHT TO COMPLY WITH LOCAL ELECTRICAL UTILITY REQUIREMENTS  
AND THE NEC.



City of Coos Bay  
500 Central Ave  
Coos Bay, Oregon 97420  
541.269.8918





## STANDARD STREET LIGHT DETAIL

DETAIL NO.








24"x6" STREET  
NAME SIGN

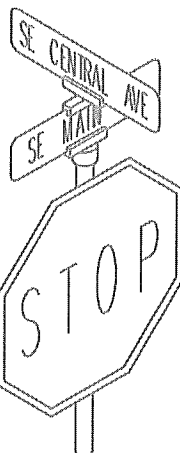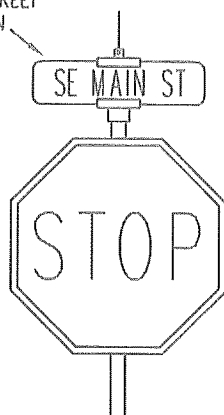

COMBINATION STOP &  
STREET NAME SIGN

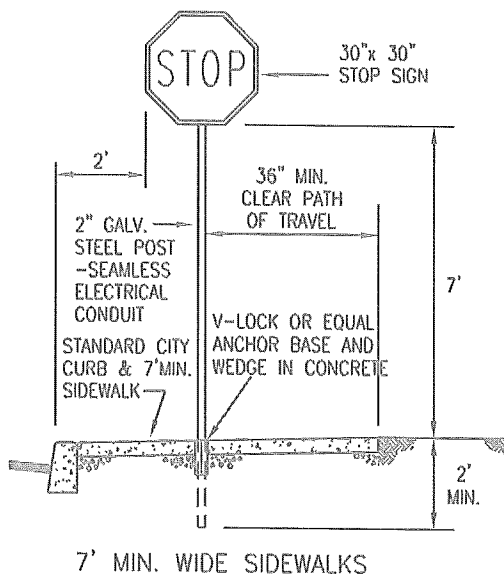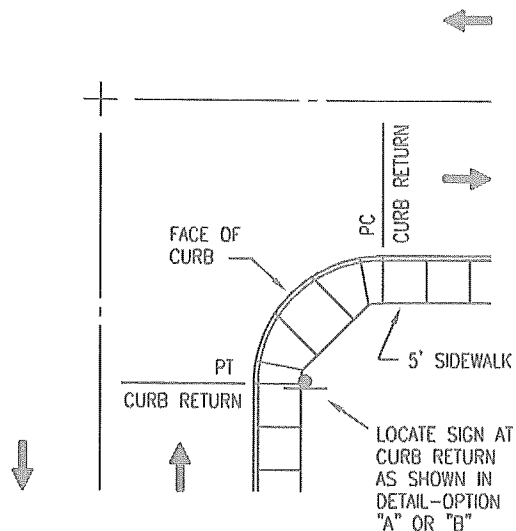

OPTION "A"

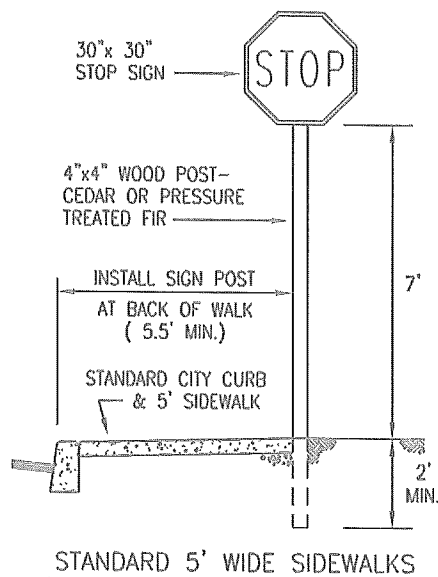


OPTION "B"

### STOP SIGN INSTALLATION


1. SIGNS TO MEET ALL FEDERAL AND STATE HIGHWAY DEPT. SPECS.
2. FACES ARE MADE OF ENGINEER GRADE REFLECTIVE 3M BRAND SCOTCHLITE.
3. ALUMINUM BACKING IS MADE OF 5052-H38 ALLOY AND IS OF 0.080 GAUGE THICKNESS.
4. STREET NAME SIGNS TO HAVE 4" WHITE LETTERS WITH GREEN BACKGROUND.
5. SIGNS SHALL BE CONNECTED TO WOOD POST WITH (4) 5/16" X 2" GALVANIZED LAG WOOD SCREWS.

DATE :	SCALE :
4/22/03	NONE
DRAWING NO.	APPROVED BY :
	JSE

TYPICAL STOP &  
STREET NAME SIGN  
COMBINATION

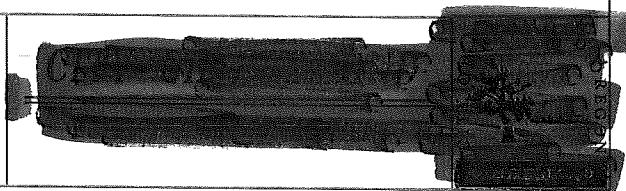



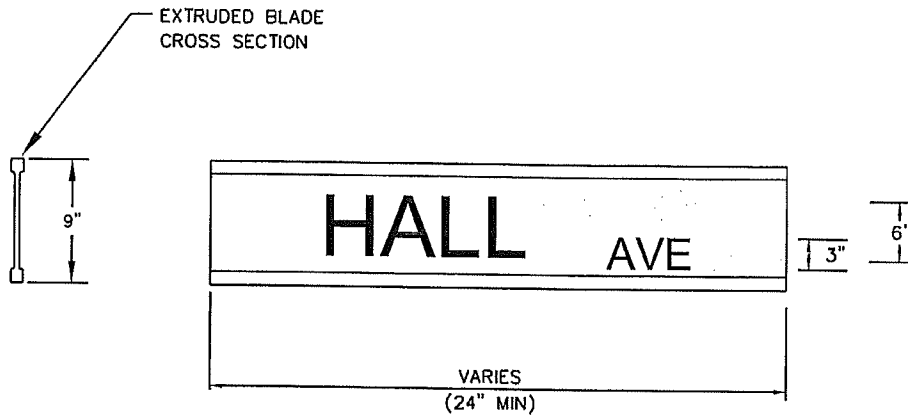

**NOTES:**

**1. MATERIALS**

STREET NAME SIGN SHALL BE 9" HEIGHT, EXTRUDED ALUMINUM. THE MINIMUM LENGTH SHALL BE 24" AND MAXIMUM LENGTH SHALL BE 36" BOTH SIDES OF STREET NAME SIGNS SHALL BE GREEN 3M SCOTCHLITE BRAND HIGH INTENSITY REFLECTIVE SHEETING WITH WHITE BORDER.

**2. LETTERING**

ALL LETTERS, NUMBERS, AND BORDERS USED TO FABRICATE A STREET NAME SIGN SHALL BE HIGH INTENSITY SILVER USING 3M SCOTCHLITE BRAND. THERE ARE TWO SIZES OF LETTERS THAT MAKE UP A STREET NAME SIGN. FOR PREFIXES, SUFFIXES, AND BLOCK NUMBERS. A 3" SERIES 'C' IS USED. THE ACTUAL NAME OF THE STREET IS A 6" SERIES 'B'. ALL STREET NAME SIGNS SHALL HAVE BLOCK NUMBERS, AS ASSIGNED BY THE CITY, WHEN INSTALLED BY CONTRACTOR.

**3. MISCELLANEOUS**

STREET NAMES SHALL BE APPROVED BY THE PUBLIC WORKS DIRECTOR PRIOR TO THE SIGNS BEING FABRICATED AND INSTALLED.

Devil Standards\CB Street Standards\sr-details-streets.dwg, T-213, 6/5/2008 3:47:11 PM, 1




City of Coos Bay  
500 Central Ave  
Coos Bay, Oregon 97420  
541.269.8918

STREET SIGN AND LETTERING  
DETAILS


DETAIL NO.





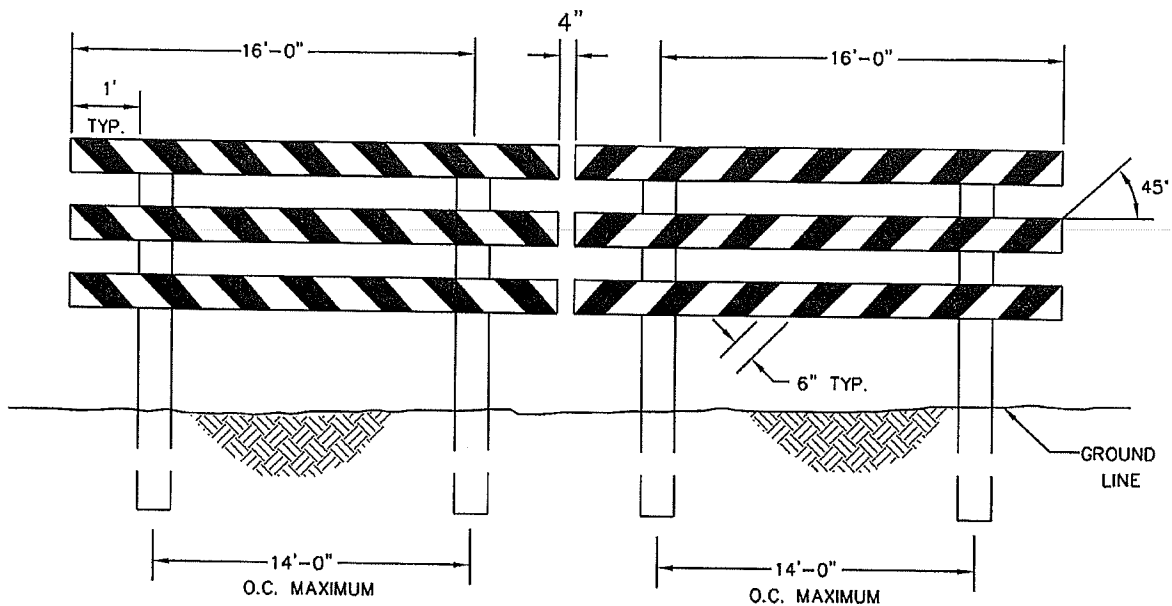

ELEVATION

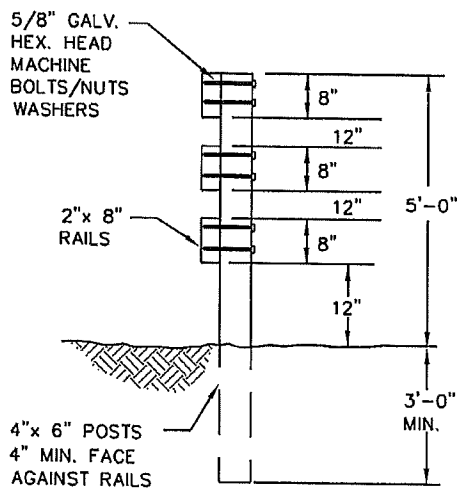

END VIEW  
N.T.S.

NOTES:

1. RAILS TO BE RETROREFLECTIVE WHITE AND ORANGE STRIPES. POSTS TO BE PRESSURE TREATED.
2. SEE MANUAL ON UNIFORM TRAFFIC CONTROL DEVICES FOR STREETS AND HIGHWAYS AND THE OREGON SUPPLEMENT.  
3F-1 BARRICADES  
6C-8 BARRICADE DESIGN  
6C-9 BARRICADE APPLICATION
3. ALL MATERIAL AND WORKMANSHIP SHALL BE IN ACCORDANCE WITH THE CURRENT STATE OF OREGON STANDARD SPECIFICATIONS FOR HIGHWAY CONSTRUCTION.
4. FOR WIDER APPLICATIONS, MULTIPLE SECTIONS AS SHOWN SHALL BE USED.



City of Coos Bay  
500 Central Ave  
Coos Bay, Oregon 97420  
541.269.8918

H B H  
Consulting  
Engineers


STANDARD PERMANENT  
BARRICADE DETAIL

DETAIL NO.

T-501

JAN 2008



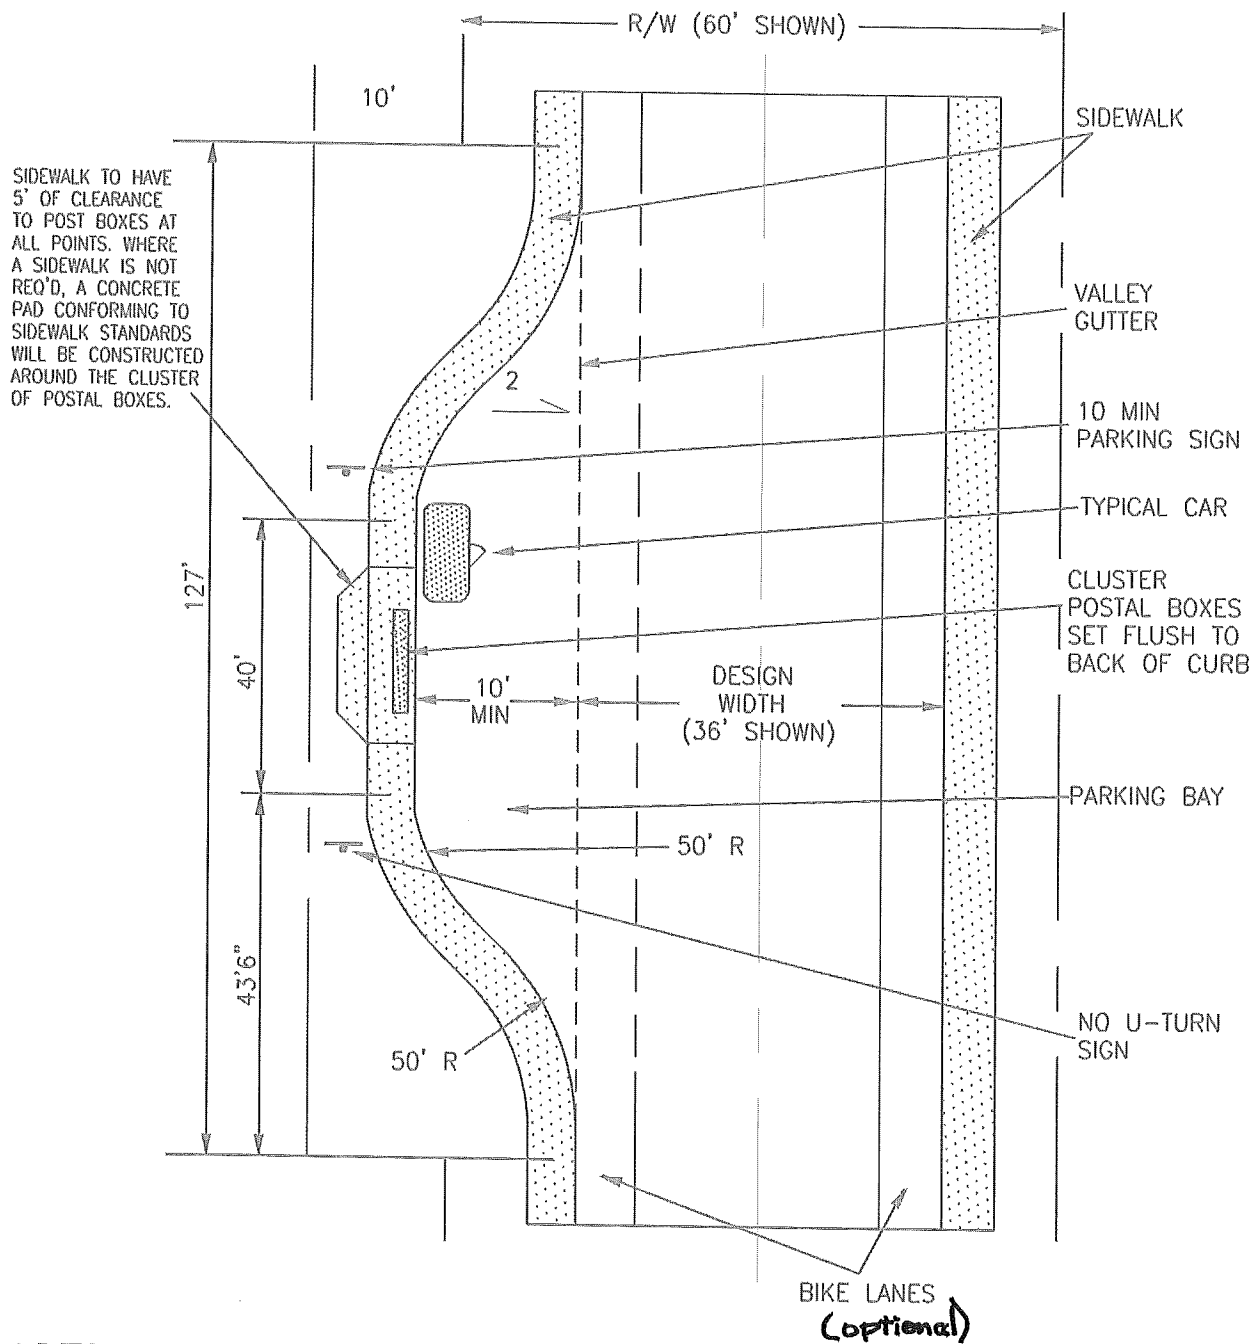


**NOTE:**

PARKING BAY IS REQUIRED ON DESIGNATED COLLECTOR STREETS (AS SHOWN). IT IS ALSO RECOMMENDED FOR LARGE INSTALLATIONS ON LOCAL STREETS.

DATE :	SCALE :	CLUSTER POSTAL DELIVERY BOX PARKING BAY	[REDACTED]
6/30/95	NONE		
DRAWING NO.	APPROVED BY :	[REDACTED]	[REDACTED]
[REDACTED]	G.KOLB		



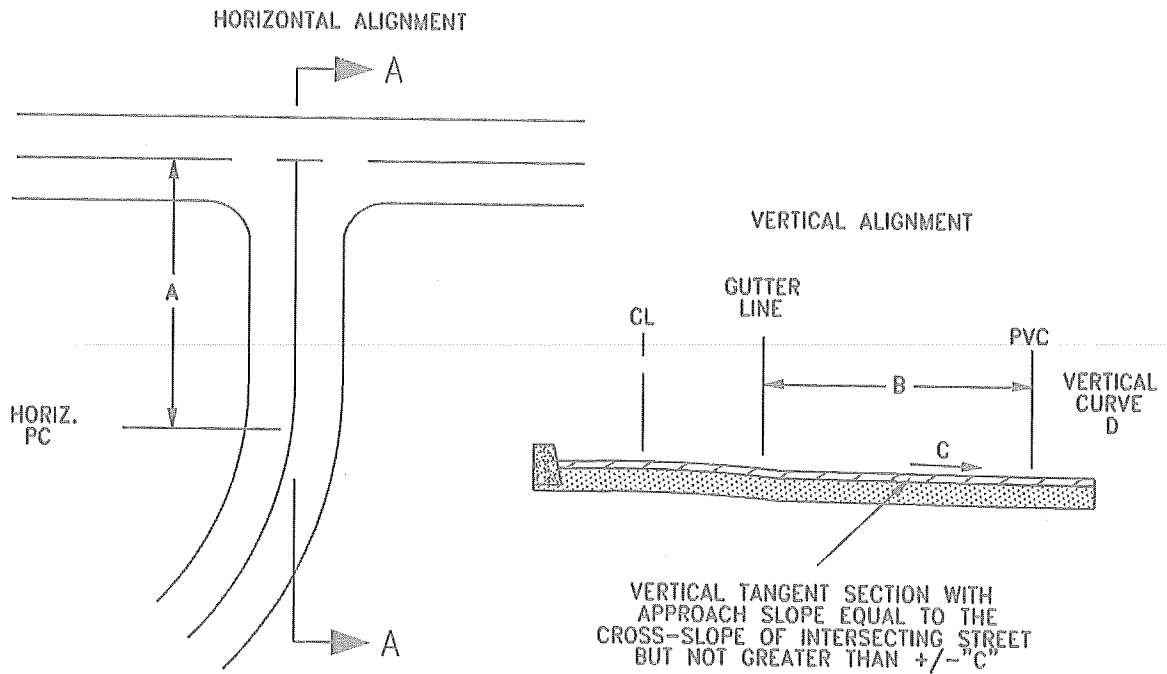

### SECTION A-A

THRU STREET	STEM STREET	A MIN.	B MIN.	C MAX. SLOPE	D MINIMUM V.C.
LOCAL/ <del>INDUSTRIAL</del>	LOCAL/ <del>INDUSTRIAL</del>	0'	0'	6%	50'
COLLECTOR	LOCAL/ <del>INDUSTRIAL</del>	50'	50'	4%	50'
COLLECTOR	COLLECTOR	100'	100'	3%	100'
ARTERIAL	LOCAL	50'	50'	4%	100'
ARTERIAL	COLLECTOR	100'	100'	2%	125'
ARTERIAL	ARTERIAL	200'	200'	2%	150'

DATE :

6/30/95

SCALE :


NONE

DRAWING NO.

APPROVED BY :

G.KOLB

"T" INTERSECTION  
ALIGNMENT STANDARD

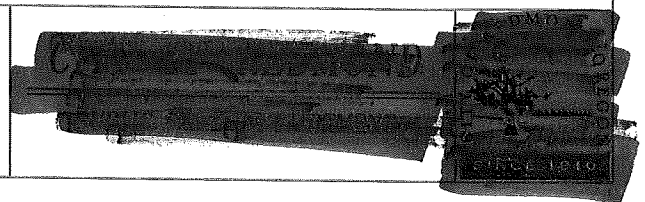



# SEWER SYSTEM

## STANDARD DETAIL DRAWINGS INDEX

~~S-050: STANDARD SERVICE CONNECTIONS~~

~~S-100: TYPICAL SEWER MAIN DETAIL~~

~~S-105: STREET CUT STANDARD DETAIL~~

~~S-150: PIPE ANCHOR / PIPE JOINT OFF MANHOLE DETAIL~~

~~S-200: STANDARD MANHOLE~~

~~S-205: BRICK SET MANHOLE~~

~~S-210: MANHOLE BASE DETAIL~~

S-220: STANDARD INSIDE DROP MANHOLE

S-225: STANDARD OUTSIDE DROP MANHOLE

~~S-250: MANHOLE COVER AND FRAME DETAILS~~ MANHOLE COVER & FRAME DETAILS.

~~S-255: MANHOLE FRAME GRADE ADJUSTMENT~~

S-300: STANDARD SERVICE CONNECTION AND LATERAL

S-400: TYPICAL PIPE CASING DETAIL

\* PROFILE OF Typical Sanitary  
Sewer Main Installation

\* Typical Sewer Service &  
Cleanout.

\* Typical Sewer Service &  
Cleanout for Duplex on Common  
Lot Line



City of Coos Bay  
500 Central Ave  
Coos Bay, Oregon 97420  
541.269.8918

H B H  
Consulting  
Engineers

STANDARD DETAIL  
DRAWING INDEX

DETAIL NO.

S-010

12/11/2007



FIBERGLASS DROP BOWL  
RELINER OR INTRAFLOW BY  
ROYAL ENVIRONMENTAL SYSTEMS  
OR APPROVED EQUAL.  
SECURE WITH SS FASTENERS.

STAINLESS STEEL STRAPS  
SECURED TO WALL WITH  
SS FASTENERS AT 4'  
INTERVALS (MIN. OF 2).  
RELINER STRAPS.

ASTM D3034 PVC  
SEWER PIPE (SDR 35)  
SIZE TO MATCH INLET  
SEWER

FILL ANNULAR SPACE WITH  
NON-SHRINK GROUT PRIOR  
TO SECURING BOWL


INLET SEWER

48"

EXTERNAL PIPE  
COUPLING (FERNCO)

DROP END CHANNEL  
(RELINER DROP END)

45° ELBOW WITH FORMED CONCRETE  
SLIDE AND CHANNEL MAY BE USED  
IN EXISTING MANHOLES

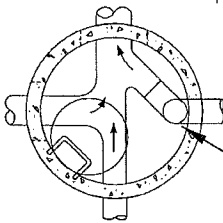

INSIDE DROP

#### NOTES:

1. DROP MANHOLES SHALL ONLY BE USED WITH PRIOR APPROVAL FROM CITY OF COOS BAY.
2. RELINER DROP BOWL, 8" OUTLET (B8) FOR 8" INLET SEWERS. B10 FOR 10" SEWERS. CONSULT CITY ENGINEER FOR LARGER SIZES.
3. EXTEND INLET SEWER PIPE 2" INTO MANHOLE. CUT "V" NOTCH IN BOTTOM OF PIPE PROTRUSION. FOLLOW RELINER INSTRUCTIONS.
4. INTRAFLOW INSIDE DROP SYSTEM ACCOMODATES 6" TO 12" SEWERS. INTRAFLOW SECTIONS SHALL BE AT LEAST 4" WIDER THAN INLET SEWER. OUTLET ELBOW TO MATCH INLET SEWER SIZE.
5. ONLY ONE DROP ASSEMBLY ALLOWED PER MANHOLE.



City of Coos Bay  
500 Central Ave  
Coos Bay, Oregon 97420  
541.269.8918




## STANDARD INSIDE DROP MANHOLE


DETAIL NO.





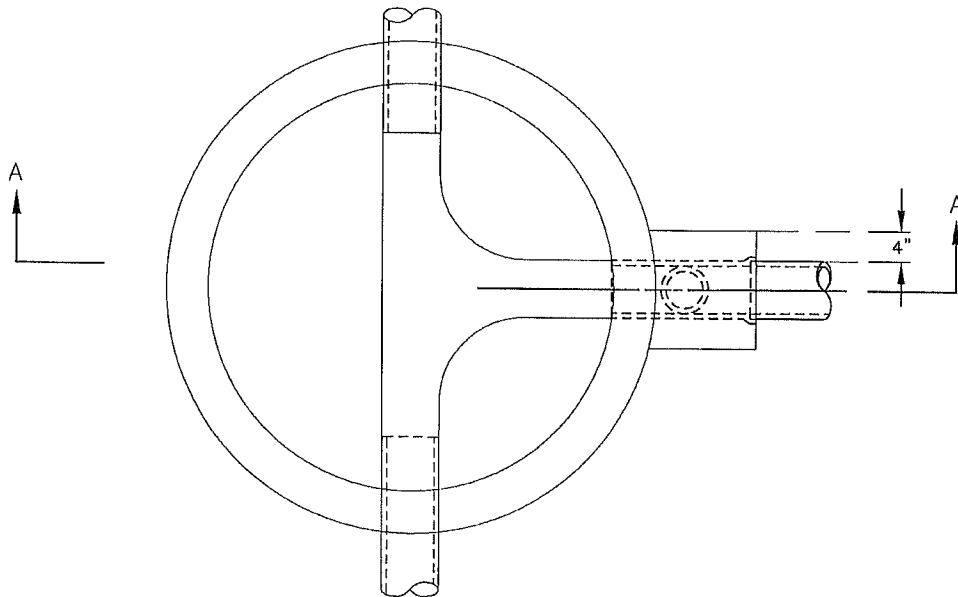

PLAN

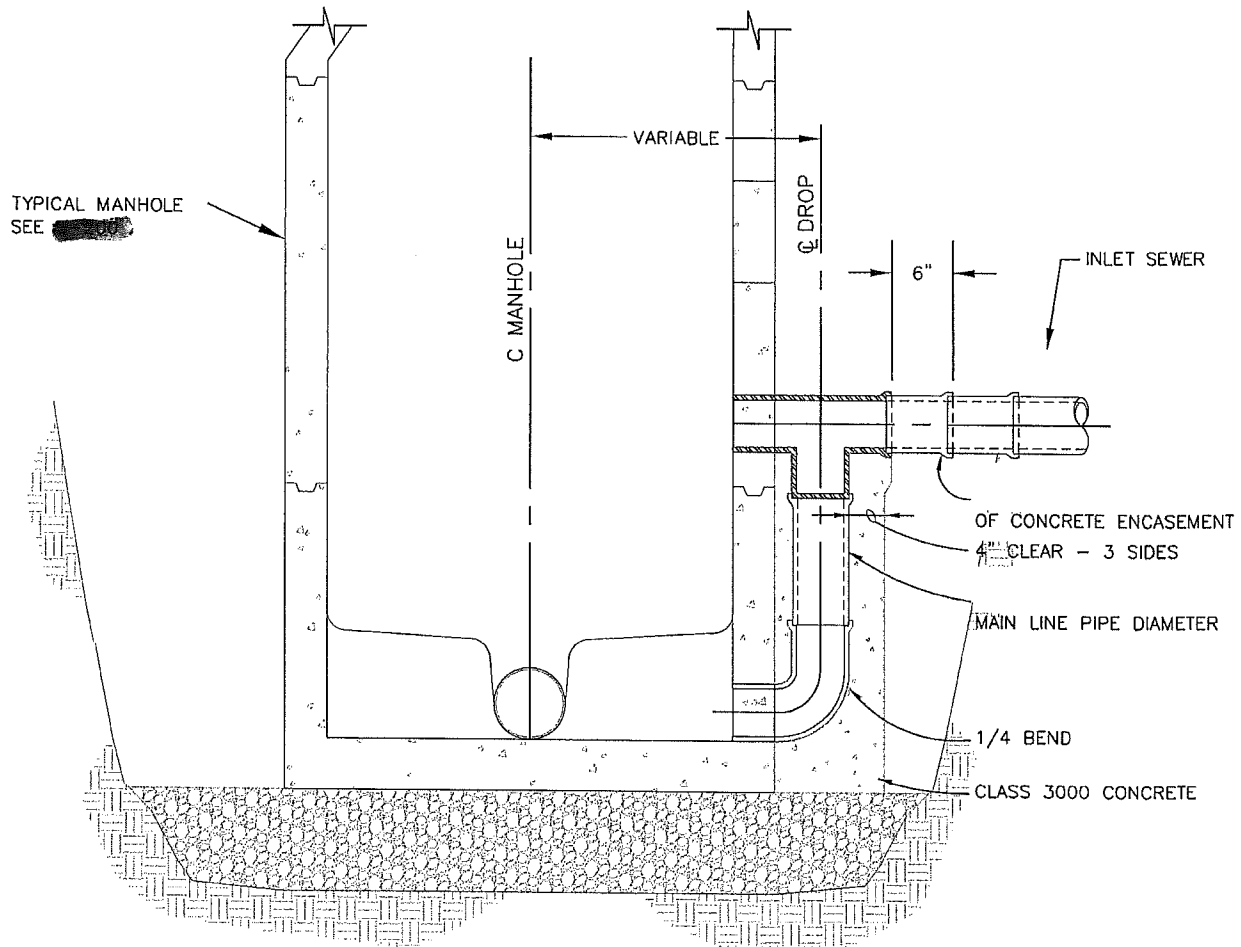

SECTION A-A



City of Coos Bay  
500 Central Ave  
Coos Bay, Oregon 97420  
541.269.8918




# STANDARD OUTSIDE DROP MANHOLE


DETAIL NO.





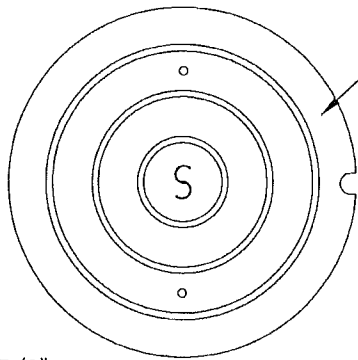


TWO HOLE 'S' COVER STANDARD  
NO VENT HOLES IN WATERTIGHT  
COVERS

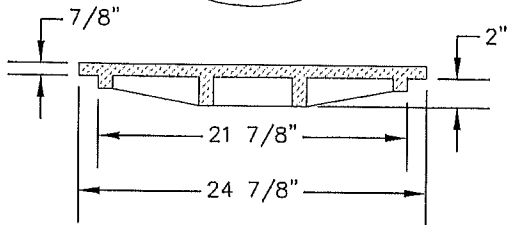

### COVER (150 LBS)

(OLYMPIC FOUNDRY MH26S, OR APPROVED EQUAL)


WATERPROOF/BOLT-DOWN COVER  
REQUIRED IN ALL EASEMENT AND  
OFF STREET AREAS.

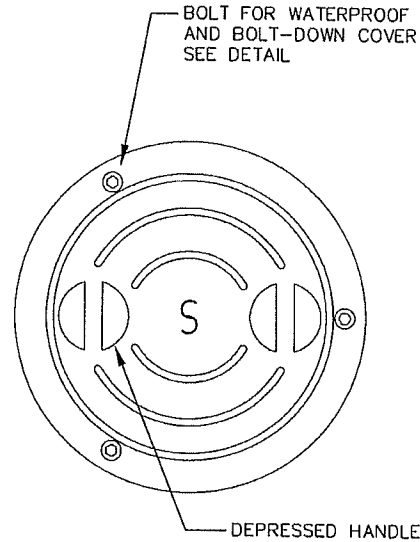

BOLT FOR WATERPROOF  
AND BOLT-DOWN COVER  
SEE DETAIL

DEPRESSED HANDLE

(OLYMPIC FOUNDRY MH26WT, OR APPROVED EQUAL)

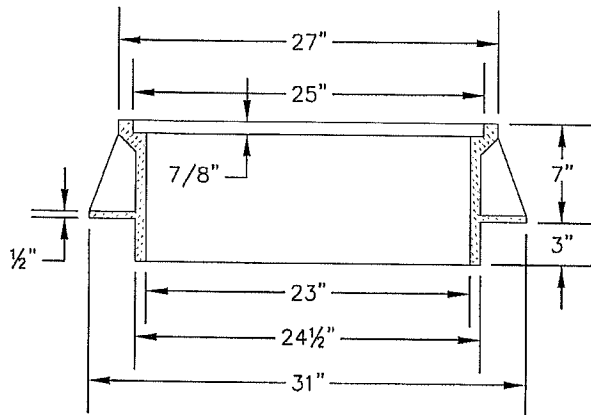

### FRAME (237 LBS)

(OLYMPIC FOUNDRY MH26A, OR APPROVED EQUAL)

1/2" - 13 NC X 1 1/2" HEX  
HEAD STAINLESS STEEL  
CAP SCREW, 3 REQ'D.

1 1/4" OD STAINLESS STEEL  
WASHER, 3/32" THICK  
3 REQ'D

FLAT RUBBER WASHER  
3 REQ'D

3/8" NEOPRENE  
GASKET

BOLT DOWN DETAIL

#### NOTE:

- 1) TAMPER PROOF FRAME AND COVER REQUIRED  
OUTSIDE OF RIGHT OF WAY OR IN  
UNDEVELOPED AREAS.
- 2) MANHOLE FRAMES AND COVER SHALL HAVE  
H-20 RATING

WORKING DRAWING BY DEPT. OF PUBLIC WORKS, CIVIL ENGINEERING, 5250, 02/2008 4/23/02 P01




City of Coos Bay  
500 Central Ave  
Coos Bay, Oregon 97420  
541.269.8918




## MANHOLE COVER AND FRAME DETAILS

DETAIL NO.

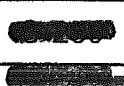




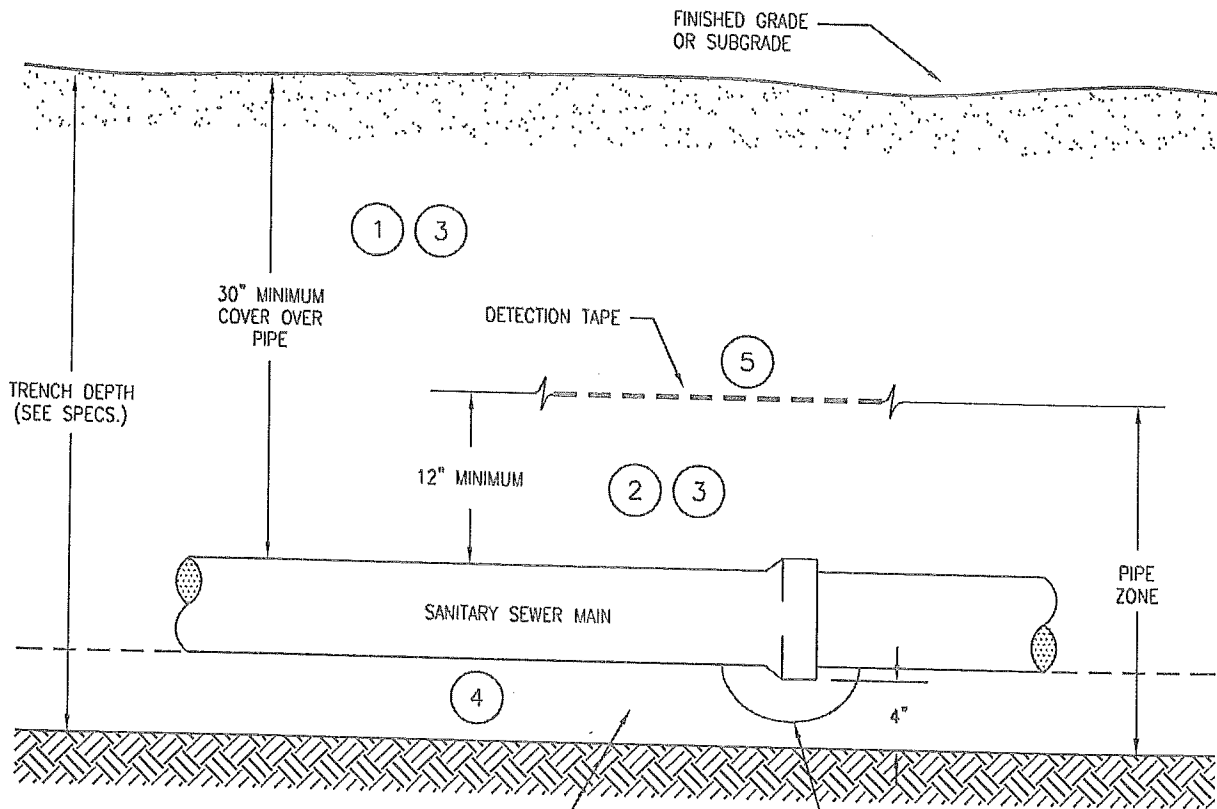



**NOTES:**


1. CLASS "A" BACKFILL COMPACTED TO 95% OF AASHTO T-99.
2. SPECIFIED PIPE ZONE MATERIAL ABOVE, AROUND, AND BELOW PIPE SHALL BE COMPACTED TO 95% OF AASHTO T-99.
3. THE ENGINEER MAY REQUIRE THIS ZONE TO BE WATER SETTLED TO PROVE THE INTEGRITY OF THE BACKFILL.
4. PIPE BEDDING SHALL MEET THE REQUIREMENTS OF DIVISION I. PIPE BEDDING SHALL BE MECHANICALLY COMPACTED TO 95% OF MAXIMUM AS DETERMINED BY AASHTO T-99.
5. DETECTION TAPE TO BE LOCATED AT TOP OF PIPE ZONE, 12" ABOVE THE PIPE.

**ALLOWABLE ENCROACHMENTS  
IN UTILITY EASEMENT**

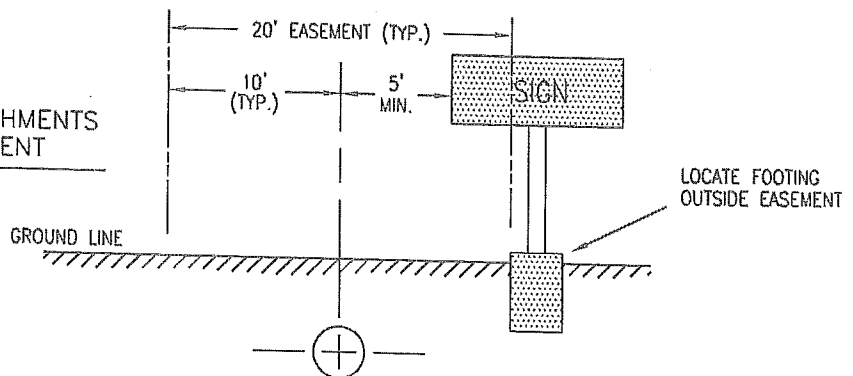

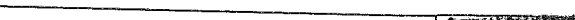DATE :	SCALE :	PROFILE OF TYPICAL SANITARY SEWER MAIN INSTALLATION	
1/6/97	NONE		
DRAWING NO.	APPROVED BY :		
	G.KOLB		



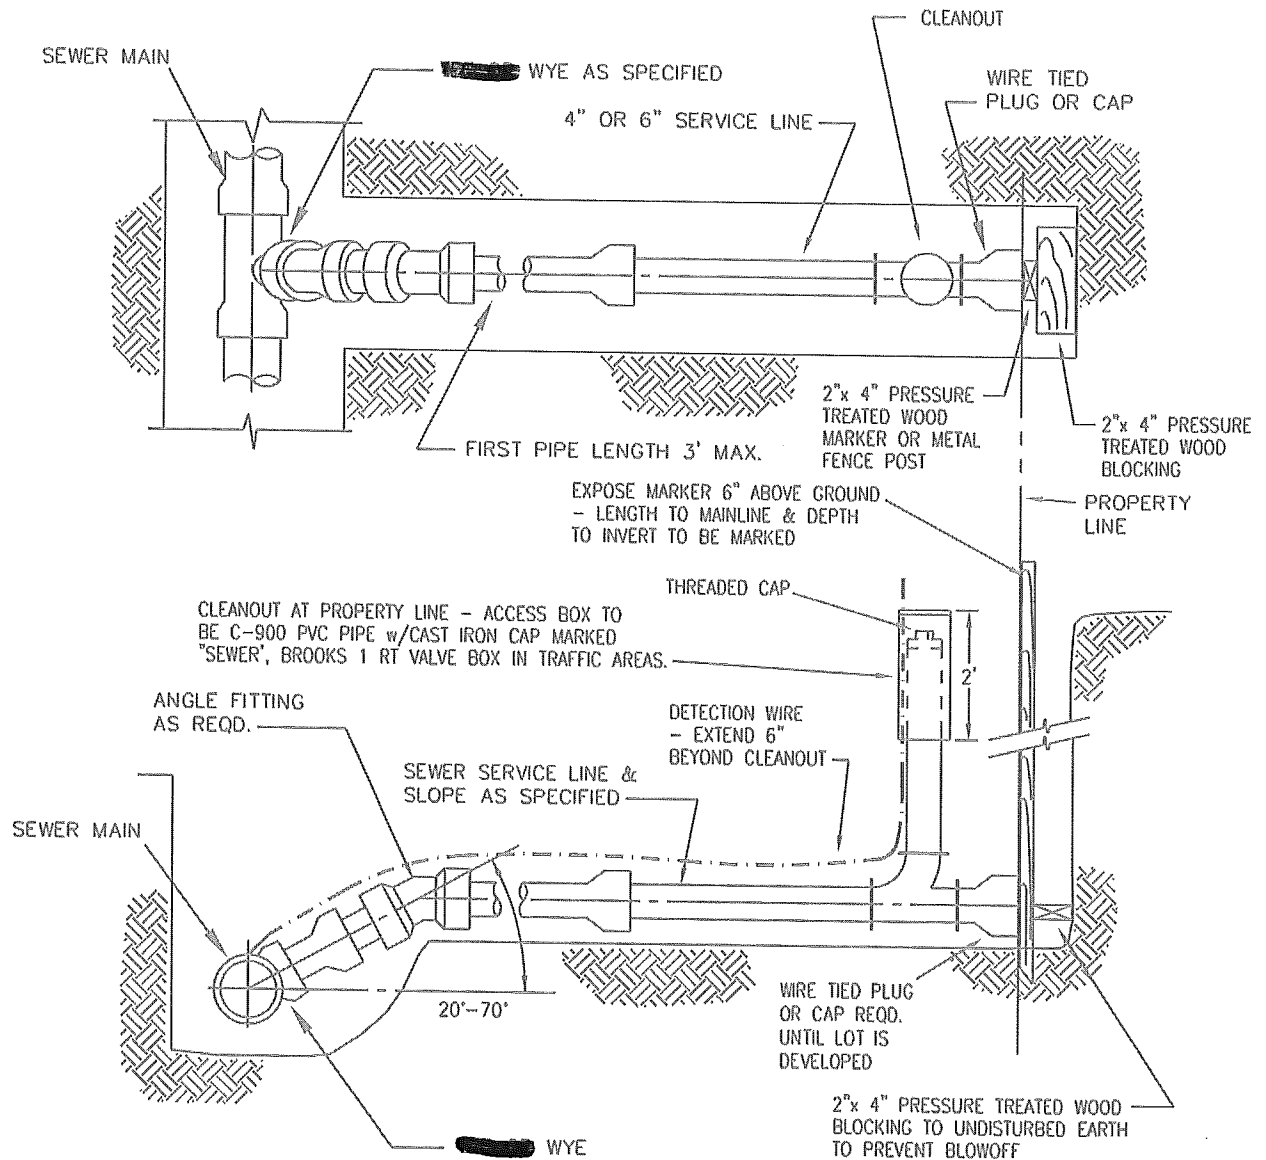


**NOTE:**

MINIMUM SLOPE TO BE 1/4" PER FOOT OR AS APPROVED BY THE CITY ENGINEER.  
 PROVIDE RUBBER RING ADAPTOR FOR CONNECTION TO SERVICE LINE WITH A CONCRETE, CLAY, OR ASBESTOS CEMENT TEE.  
 WHERE NO TEE IS PROVIDED, A SERVICE SADDLE OF PROPER SIZE SHALL BE INSTALLED UNDER THE SUPERVISION OF THE CITY.  
 ALL TRENCH BACKFILL TO CONFORM TO CITY OF [REDACTED] STANDARDS AND SPECIFICATIONS FOR SEWER MAIN. MINIMUM SERVICE TRENCH WIDTH IS 24".  
 ALL SERVICE LINES SHALL END WITH A CLEANOUT AT THE PROPERTY LINE.  
 SEWER SERVICE LINES SHALL NOT HAVE LESS THAN 3.0' OF COVER UNDER ROADWAY AND 2.0' OF COVER TO NATURAL GROUND IN THE RIGHT OF WAY.

DATE :	SCALE :	TYPICAL SEWER SERVICE & CLEANOUT	[REDACTED]	[REDACTED]
4/22/03	NONE			
DRAWING NO.	APPROVED BY :		[REDACTED]	[REDACTED]
[REDACTED]	JSE			



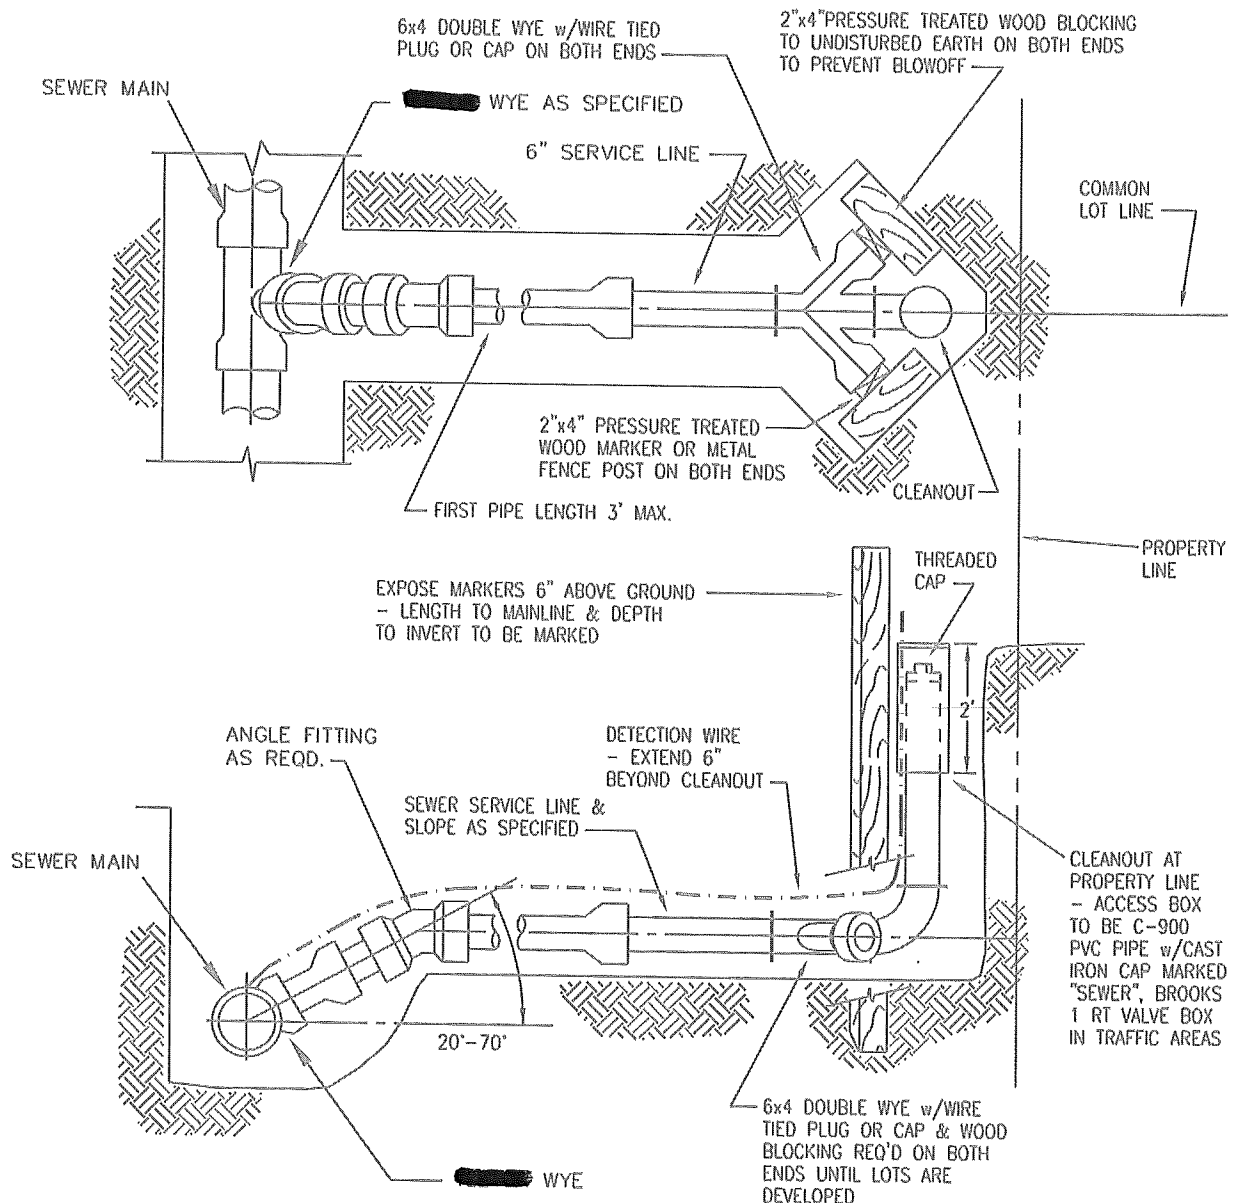

**NOTE:**

MINIMUM SLOPE TO BE 1/4" PER FOOT OR AS APPROVED BY THE CITY ENGINEER.  
 PROVIDE RUBBER RING ADAPTOR FOR CONNECTION TO SERVICE LINE WITH A CONCRETE, CLAY, OR ASBESTOS CEMENT TEE.  
 WHERE NO TEE IS PROVIDED, A SERVICE SADDLE OF PROPER SIZE SHALL BE INSTALLED UNDER THE SUPERVISION OF THE CITY.  
 ALL TRENCH BACKFILL TO CONFORM TO CITY OF [REDACTED] STANDARDS AND SPECIFICATIONS FOR SEWER MAIN. MINIMUM SERVICE TRENCH WIDTH IS 24".  
 ALL SERVICE LINES SHALL END WITH A CLEANOUT AT THE PROPERTY LINE.  
 SEWER SERVICE LINES SHALL NOT HAVE LESS THAN 3.0' OF COVER UNDER ROADWAY AND 2.0' OF COVER TO NATURAL GROUND IN THE RIGHT OF WAY.

DATE :	SCALE :	TYPICAL SEWER SERVICE & CLEANOUT FOR DUPLEX ON COMMON LOT LINE	[REDACTED]	[REDACTED]
4/22/03	NONE			
DRAWING NO.	APPROVED BY :	[REDACTED]	[REDACTED]	[REDACTED]
[REDACTED]	JSE			



# STORM DRAINAGE

## STANDARD DETAIL DRAWINGS INDEX

~~D-000: STANDARD UTILITY CONNECTIONS~~

~~D-100: TYPICAL STORM DRAIN TRENCH DETAIL~~

~~D-105: STREET CUT STANDARD DETAIL~~

~~D-150: PIPE ANCHOR / TRENCH CUT-OFF WALL DETAIL~~

~~D-200: STANDARD MANHOLE~~

D-201: POLLUTION CONTROL MANHOLE

~~D-205: FLAT TOP MANHOLE~~

~~D-210: MANHOLE BASE STANDARD DETAILS~~

D-220: STANDARD INSIDE DROP MANHOLE W/ DEFLECTION PLATE

D-250: ~~MANHOLE COVER AND FRAME DETAILS~~ MANHOLE COVER &  
FRAME DETAILS

D-260: ~~MANHOLE FRAME GRADE ADJUSTMENT~~

D-300: STANDARD INLETS, FRAMES & GRATES

D-301: TRAPPED/POLLUTION CONTROL CATCH BASIN

D-302: DITCH INLET

D-303: AREA DRAIN INLET

D-304: HEADWALL WITH TIDE GATE

*PROFILE OF TYPICAL SANITARY SEWER MAIN  
INSTALLATION*



City of Coos Bay  
500 Central Ave  
Coos Bay, Oregon 97420  
541.269.8918




STANDARD DETAIL  
DRAWING INDEX

DETAIL NO.





CAST IRON (H-20 RATED)  
MANHOLE COVER AND FRAME, SEE  
STANDARD DETAIL ~~01-20-01~~

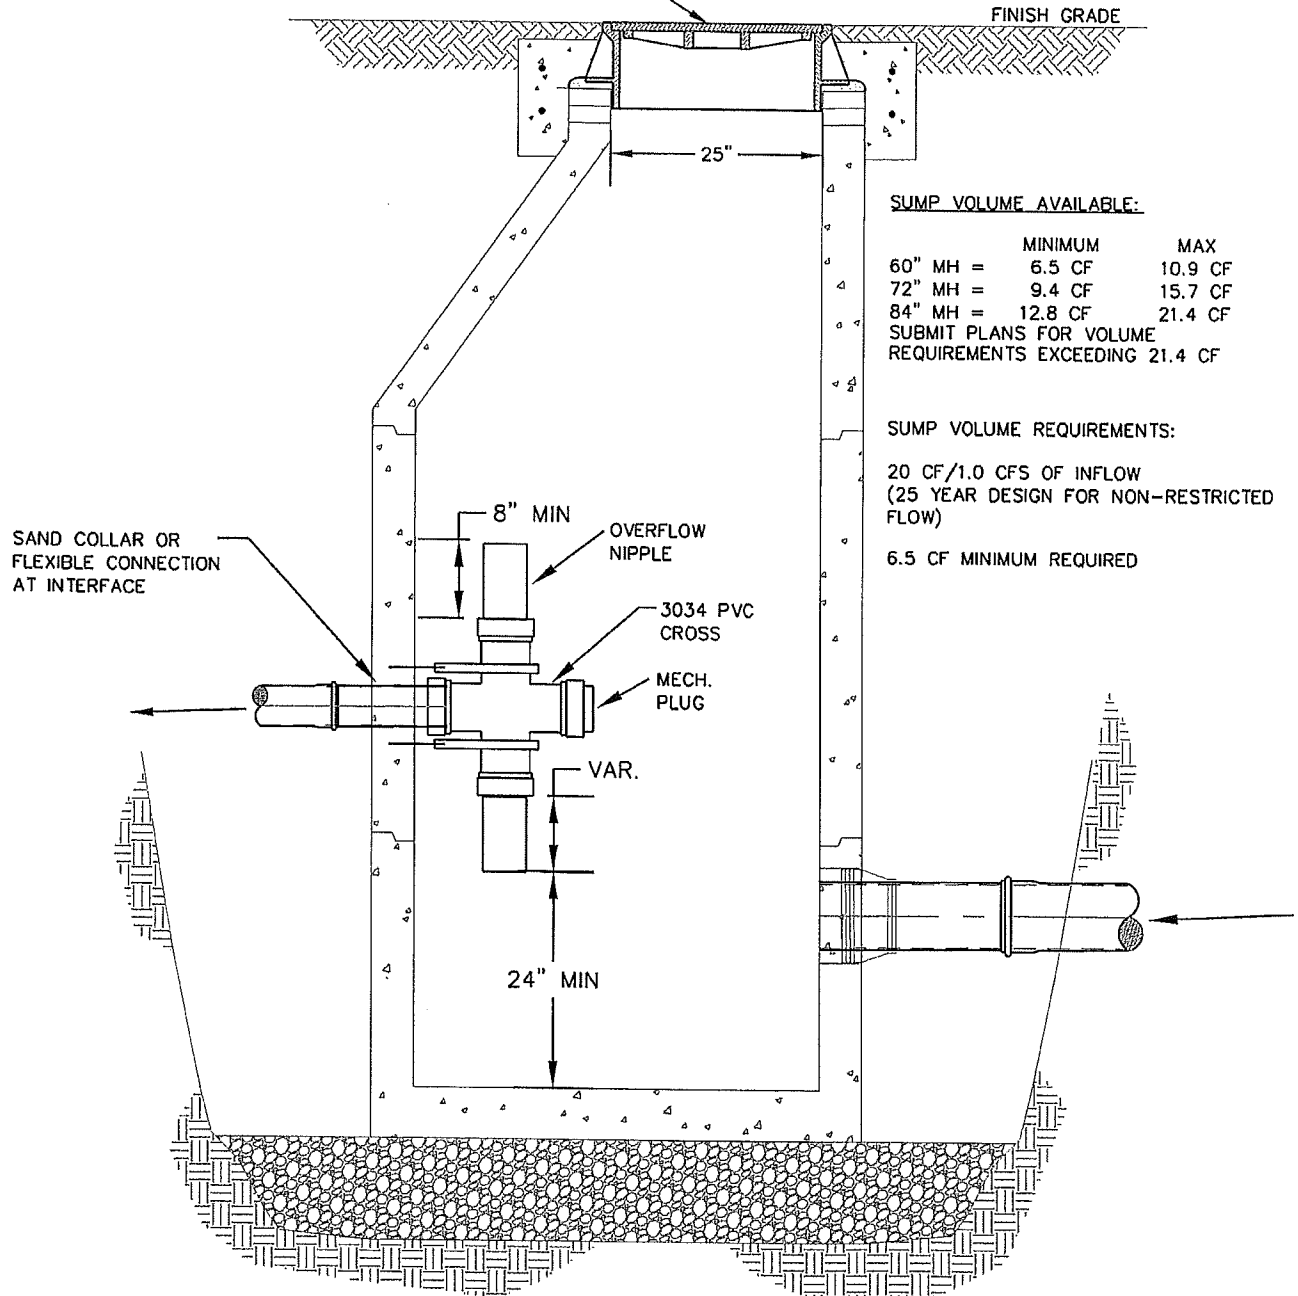

SUMP VOLUME AVAILABLE:

	MINIMUM	MAX
60" MH =	6.5 CF	10.9 CF
72" MH =	9.4 CF	15.7 CF
84" MH =	12.8 CF	21.4 CF

SUBMIT PLANS FOR VOLUME  
REQUIREMENTS EXCEEDING 21.4 CF

SUMP VOLUME REQUIREMENTS:

20 CF/1.0 CFS OF INFLOW  
(25 YEAR DESIGN FOR NON-RESTRICTED  
FLOW)


6.5 CF MINIMUM REQUIRED

FOR STANDARD MANHOLE DETAILS,  
~~01-20-01~~

FOR FLAT TOP MANHOLE DETAILS,  
~~01-20-01~~



City of Coos Bay  
500 Central Ave  
Coos Bay, Oregon 97420  
541.269.8918

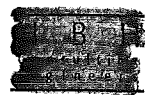


## STORM DRAIN POLLUTION CONTROL MANHOLE

DETAIL NO.




01-20-01



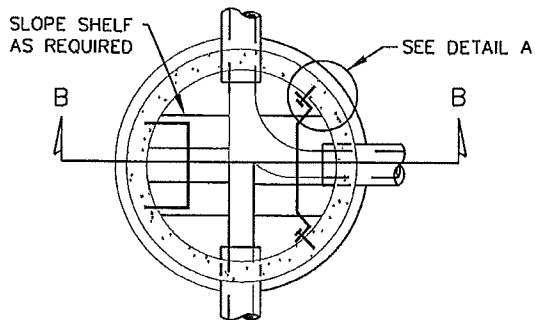


SECTION A-A

1/2"  $\phi$  SELF TAPPING  
CONCRETE ANCHORS,  
PHILLIPS S-12 OR  
APPROVED EQUAL, w/  
1/2"  $\phi$  x 1-1/2" Lg.  
STAINLESS STEEL  
BOLT & STAINLESS  
STEEL LOCK WASHER.

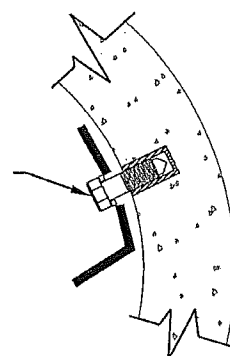


DETAIL A  
(PARTITION ATTACHMENT)

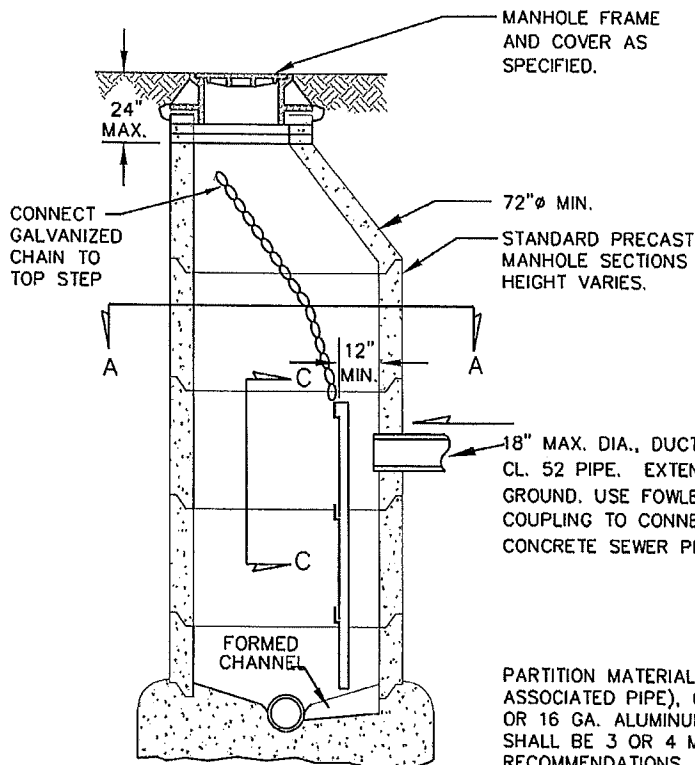

SECTION B-B

REMOVABLE DEFLECTION PLATE  
(PIPE DIA. + 6" WIDTH MINIMUM)  
MATERIAL TO BE STAINLESS  
STEEL, ALUMINUM, FIBERGLASS OR  
HDPE PLATE. TOP PARTITION TO  
BE CUT SO THAT BOTTOM OF CUT  
MATCHES THE INVERT OF THE  
INCOMING PIPE. THE RADIUS OF  
THE CUT SHOULD MATCH THAT OF  
THE INSIDE OF THE INCOMING PIPE.

CHAIN TO  
TOP STEP

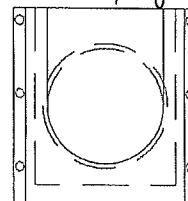

SECTION C-C

18" MAX. DIA., DUCTILE IRON,  
CL. 52 PIPE. EXTEND TO UNDISTURBED  
GROUND. USE FOWLER OR FERNCO  
COUPLING TO CONNECT PVC OR  
CONCRETE SEWER PIPE.


PARTITION MATERIAL SHALL BE 1/2" H.D.P.E. (TYPICAL PER  
ASSOCIATED PIPE), OR 1/8" FIBERGLASS (TYPICAL PER PIPE INC.),  
OR 16 GA. ALUMINUM OR 18 GA. STAINLESS STEEL. FIBERGLASS  
SHALL BE 3 OR 4 MAT LAYUP PER MANUFACTURER'S  
RECOMMENDATIONS. MAXIMUM FLOW IS 3 CFS FOR INSIDE DROP  
MANHOLE. FOR A 48" DIAMETER MANHOLE, THE MAXIMUM  
INCOMING PIPE DIAMETER IS 18". A LARGER DIAMETER INCOMING  
PIPE WILL REQUIRE A SPECIAL DESIGN AND APPROVAL BY THE CITY.

**NOTES:**


1. INSIDE DROP MANHOLES WITH DEFLECTION PLATE SHALL ONLY BE USED WITH PRIOR APPROVAL FROM CITY.
2. ONLY ONE DROP ASSEMBLY ALLOWED PER MANHOLE.






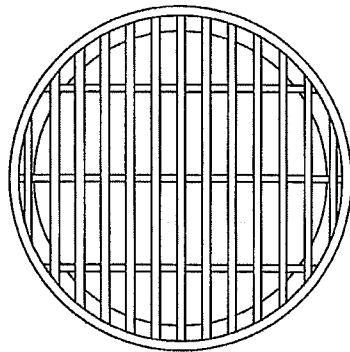

GRATE  
(OLYMPIC FOUNDRY #MH26G,  
OR APPROVED EQUAL)

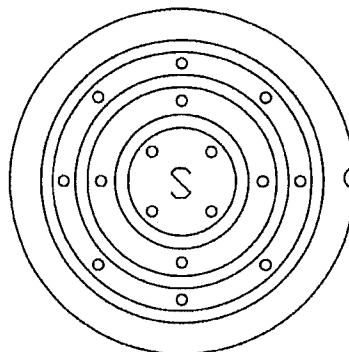

STORM  
(OLYMPIC FOUNDRY #MH26P  
OR APPROVED EQUAL)

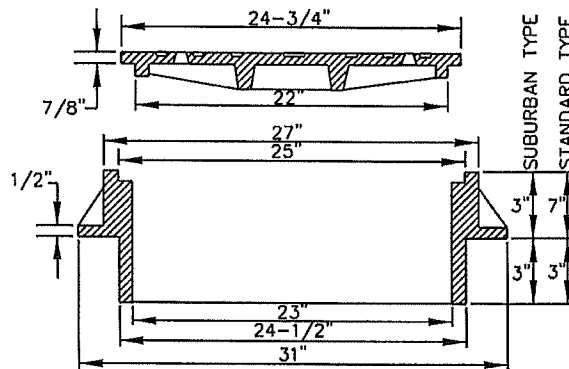

FRAME  
(OLYMPIC FOUNDRY #MH26A,  
OR APPROVED EQUAL)

NOTES:

1. USE SUBURBAN TYPE ONLY IN NON-TRAFFIC AREAS, AND ONLY WITH APPROVAL BY THE CITY.
2. COVER AND FRAME SHALL BE GRAY CAST IRON ASTM A-48 CLASS 30.
3. COVER AND FRAME TO BE MACHINED TO A TRUE BEARING ALL AROUND.
4. NOTCH LID FOR LIFTING HOOK.
5. OPEN GRATES REQUIRE APPROVAL BY CITY, AND MUST BE BICYCLE SAFE IF USED IN TRAFFIC AREAS.



City of Coos Bay  
500 Central Ave  
Coos Bay, Oregon 97420  
541.269.8918




# MANHOLE COVER AND FRAME DETAILS

DETAIL NO.


JAN. 2008



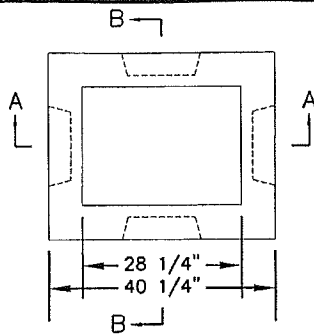


TOP VIEW

INLET TYPE	W	W1
G-1	2' 8-7/8"	1' 8-7/8"
G-2, G-2M	3' 3-3/8"	2' 3-3/8"

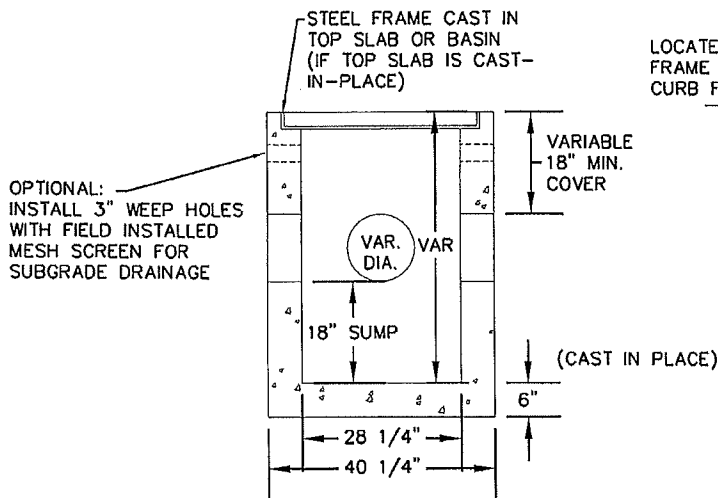

SECTION A-A

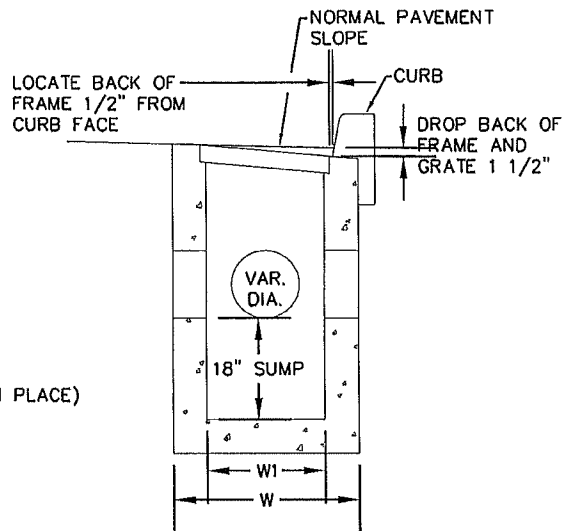


SECTION B-B

NOTES:


1. CONCRETE STRENGTH SHALL BE 3300 PSI.
2. PRECAST BASE WALLS SHALL BE A MINIMUM 4" THICK. CAST-IN-PLACE BASE WALLS SHALL BE 6" THICK.

TYPE	W	I.W
STANDARD	1'-9"	1'-8 1/4"


TYPE	DIA. PIPE	W	I.W
STANDARD	10"-12"	1'-10 3/4"	1'-9 3/8"

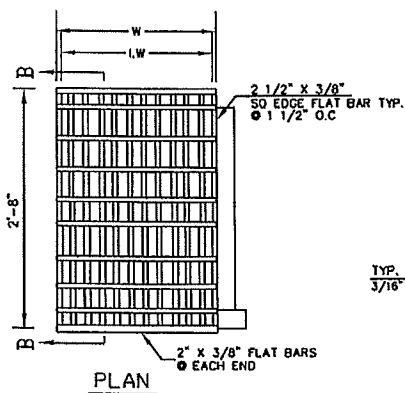

PLAN

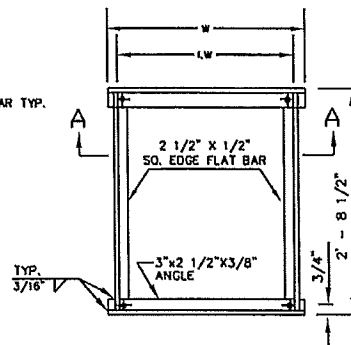


PLAN

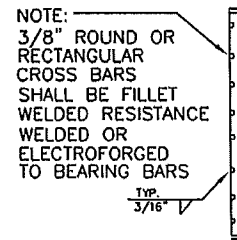

SECTION B-B


NOTE:  
USE VERTICAL BEADS IN CORNERS,  
FILLET WELD JOINT ON BOTTOM OF  
FRAME. GRATE MUST REST FLAT ON  
FRAME SURFACE.

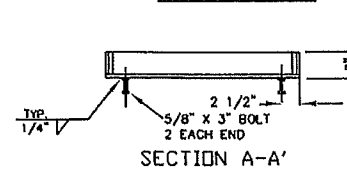

SECTION A-A'



City of Coos Bay  
500 Central Ave  
Coos Bay, Oregon 97420  
541.269.8918


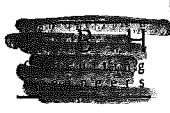


STANDARD INLETS,  
FRAMES & GRATES

DETAIL NO.






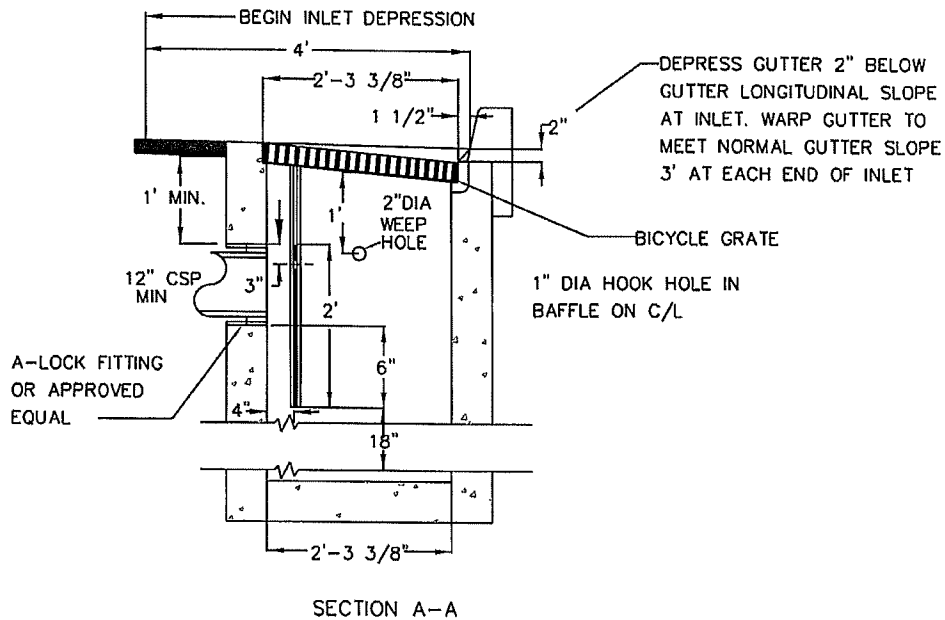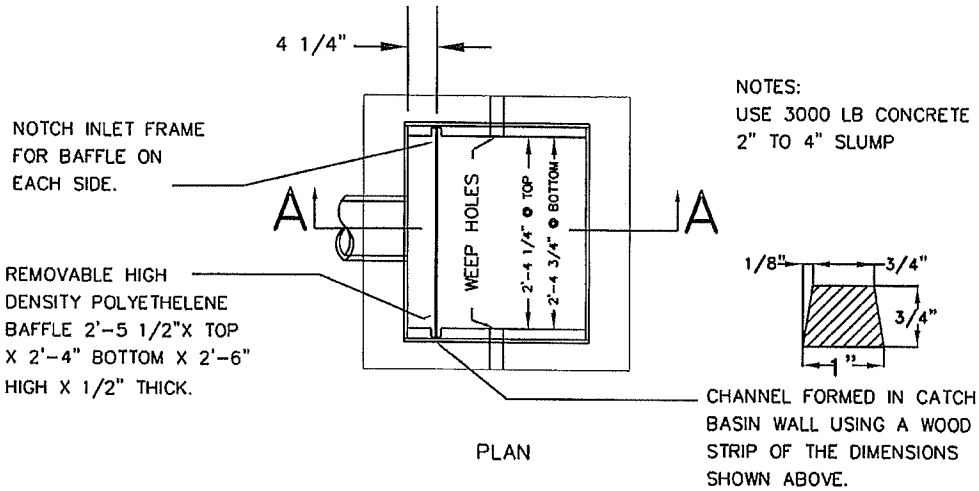

301-65/2008 43959 Rev. 5/11



City of Coos Bay  
500 Central Ave  
Coos Bay, Oregon 97420  
541.269.8918

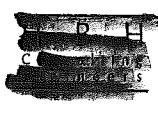


TRAPPED/POLLUTION CONTROL  
CATCH BASIN

DETAIL NO.


001

002





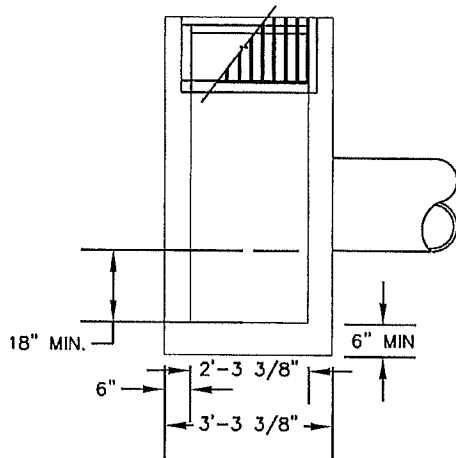

SECTION B-B

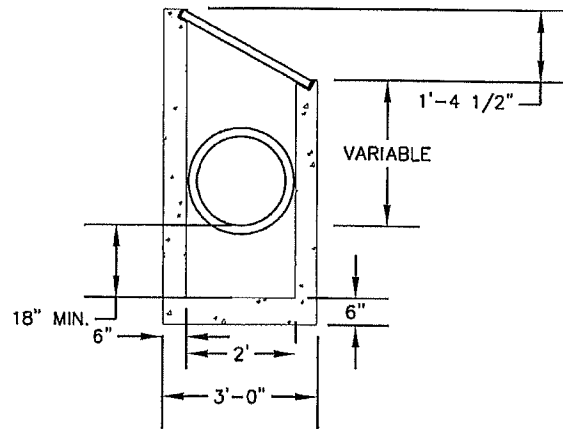

SECTION A-A

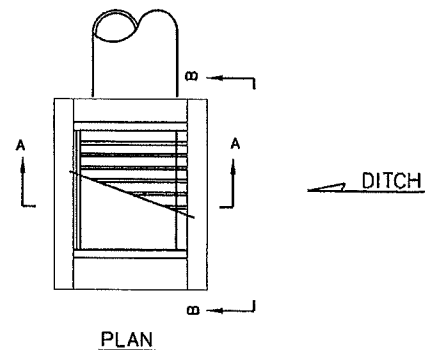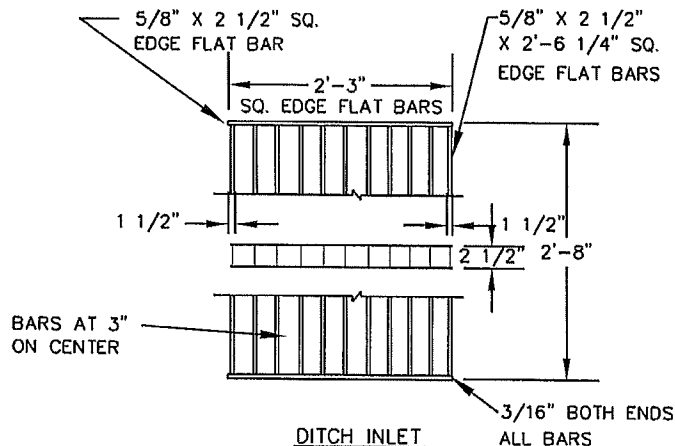

NOTES:

1. CONCRETE STRENGTH SHALL BE 3300 PSI.
2. CATCH BASIN, FRAME, AND GRATES SHALL MEET H2O LOADING.
3. INSIDE FRAME DIMENSIONS: 2'-3 3/8", 2'-8 1/2".
4. 3/8" CROSS BARS SHALL BE FLUSH WITH THE GRATE SURFACE AND MAY BE FILLET WELDED, RESISTANCE WELDED OR ELECTROFORGED TO BEARING BARS.
5. DITCH INLET CATCH BASINS SHALL MEET THE REQUIREMENTS OF ODOT DITCH INLET TYPE "D"



City of Coos Bay  
500 Central Ave  
Coos Bay, Oregon 97420  
541.269.8918





TYPICAL DITCH INLET  
AND GRATE

DETAIL NO.

1-002

2005



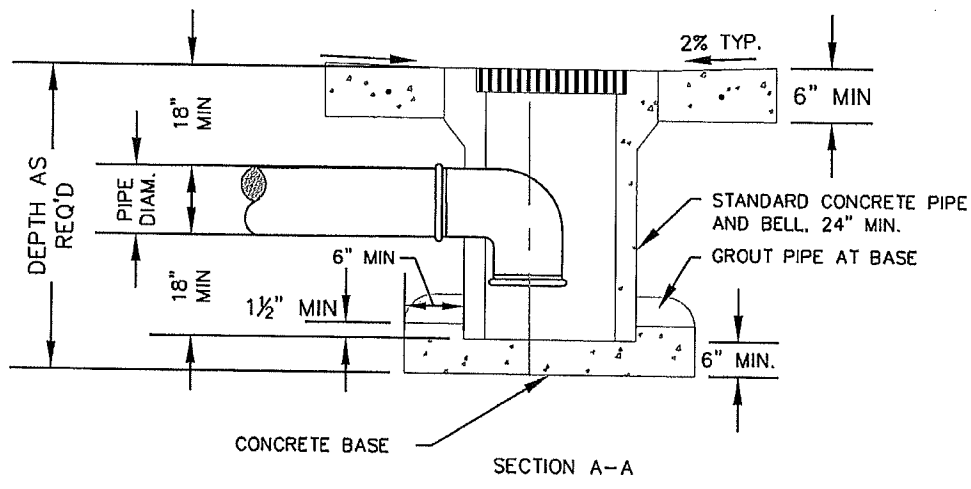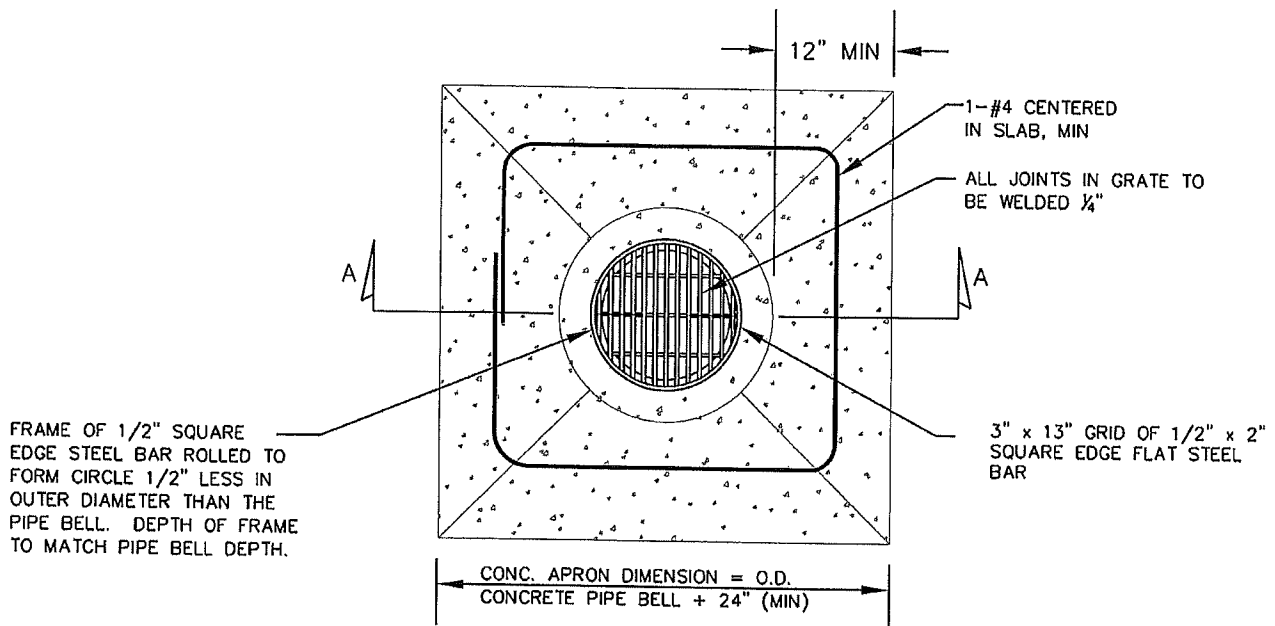

NOTES:

1. GRATES SHALL BE CONSTRUCTED FOR BICYCLE SAFETY.
2. PRECAST CONCRETE CATCH BASINS MAY BE USED FOR AREA DRAINS WHEN APPROVED BY THE CITY.
3. NOT FOR USE IN VEHICULAR TRAFFIC AREAS.



City of Coos Bay  
500 Central Ave  
Coos Bay, Oregon 97420  
541.269.8918




# TYPICAL AREA DRAIN INLET

DETAIL NO.





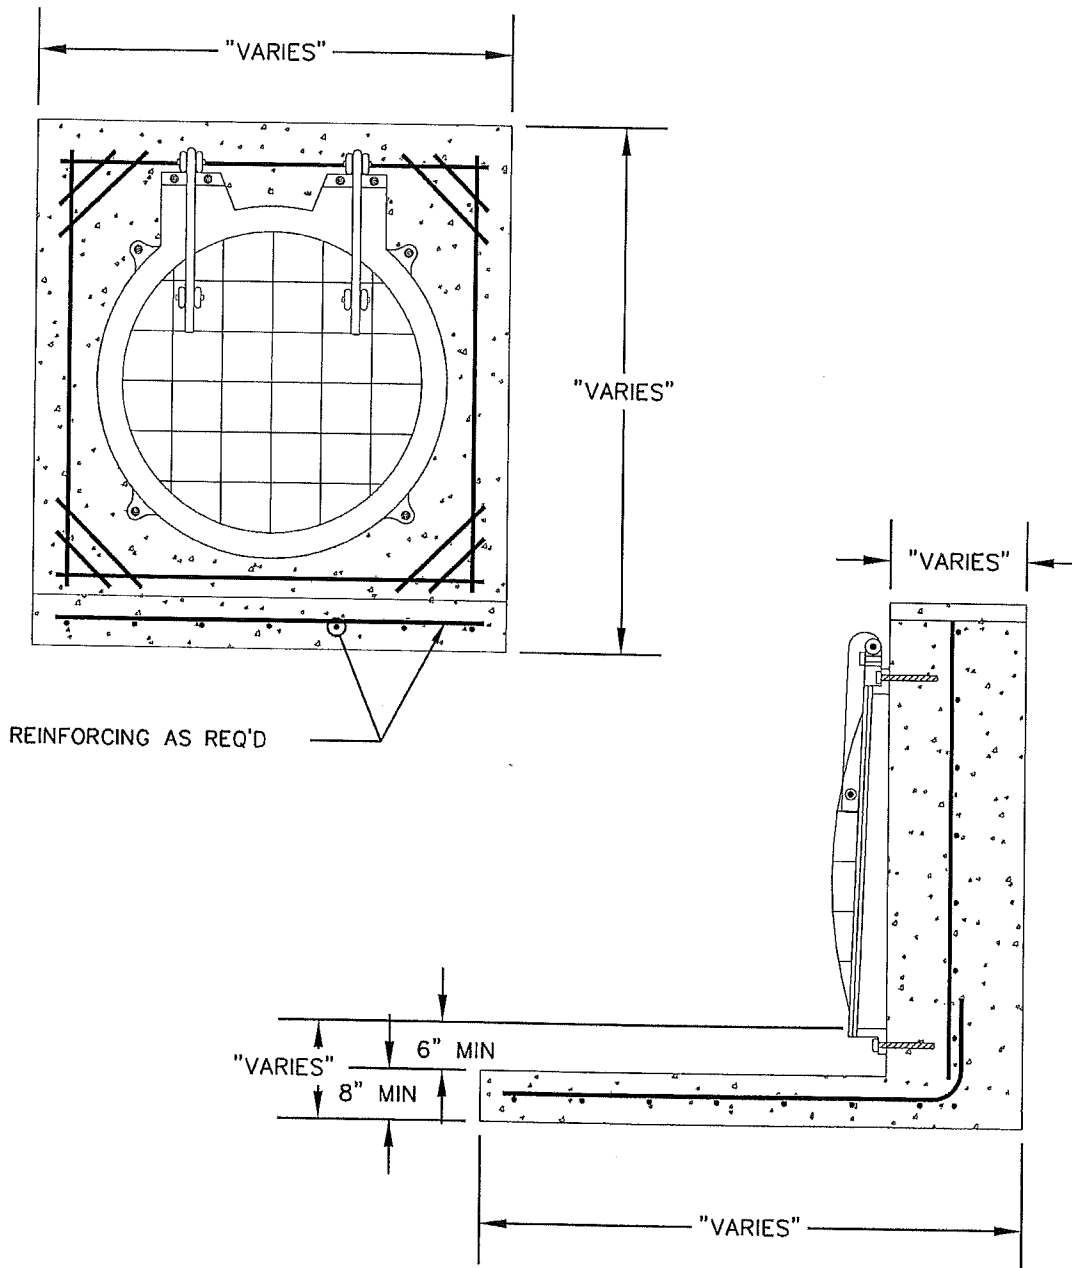

NOTE:

- 1) OUTFALL HEADWALL SHOWN FOR CLARITY ONLY - ALL OUTFALLS SHALL BE SITE SPECIFIC AND SHALL CONFORM TO THE REQUIREMENTS OF ALL FEDERAL, STATE AND LOCAL REGULATIONS.
- 2) OUTFALL SHALL BE ABOVE THE MEAN LOW WATER LEVEL EXCEPT AS APPROVED BY CITY ENGINEER. INSTALLATION OF TIDEGATE MAY BE REQUIRED WHEN OUTFALL IS IN A TAILWATER CONDITION.
- 3) ALL TIDEGATES, FLAPGATES OR OTHER OUTLET GATES INSTALLED ON SPECIFIC OUTFALLS SHALL MEET THE REQUIREMENTS OF ODFW, NOAA AND OTHER AGENCIES AS REQUIRED.
- 4) CONCRETE STRENGTH SHALL BE 3,300 PSI AFTER 28 DAYS.
- 5) PROVIDE REINFORCING AS REQUIRED.

11



City of Coos Bay  
500 Central Ave  
Coos Bay, Oregon 97420  
541.269.8918



## HEADWALL WITH TIDEGATE

DETAIL NO.

